


Map No. 1002 K11 Sec. 20 Twp. 28 R. 4

Well No. 25 Smith
Empire Company
Contractor

NORTH

WEST

EAST

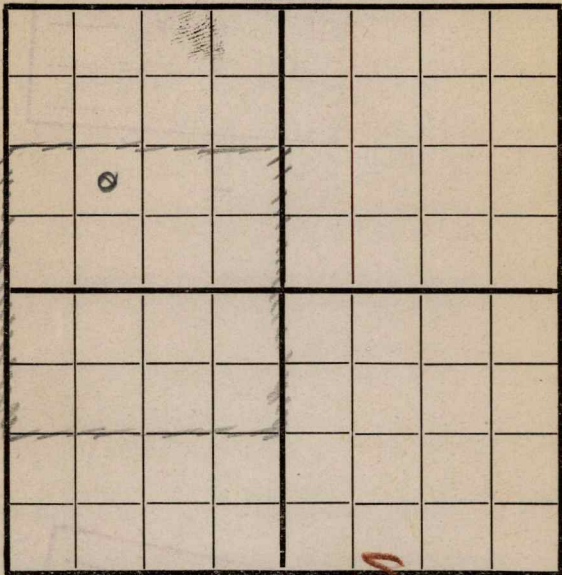

SOUTH

~~9908 1/2 x 9908 1/2~~

RECORD

Location

Cased in., ft.

Rig up

Sand

Drilling and Remarks:

Gas

Oil

Total Depth

FIRST REPORT

PRODUCTION

1st 24 hrs. Nat.

1st 24 hrs. after shot

Gas Cu. Ft.

Dry Hole

Abandoned

Date

8/2 191 8 Candy Scout

Map No. _____ Sec. 20 Twp. 28 R. 4

Well No. 25 Smith


Empire Company

Contractor

NORTH

WEST

EAST

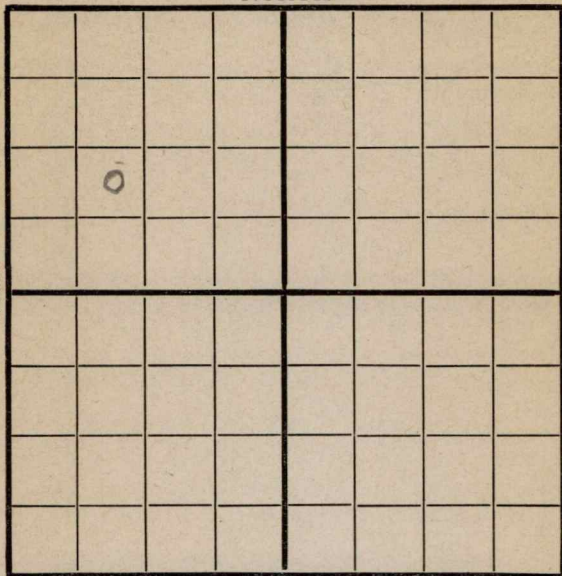

SOUTH

990 W 4A

Location _____

Rig up

Drilling and Remarks:

RECORD

Cased _____ in., _____ ft.

Sand _____

Gas _____

Oil _____

Total Depth _____

PRODUCTION

1st 24 hrs. Nat. _____

1st 24 hrs. after shot _____

Gas _____ Cu. Ft.

Dry Hole _____

Abandoned _____

Date

8/7


191

J. Corby

Scout

Map No. _____ Sec. 30 Twp. 28 R. 4

Well No. 25 Smith
Engine Company
 _____ Contractor

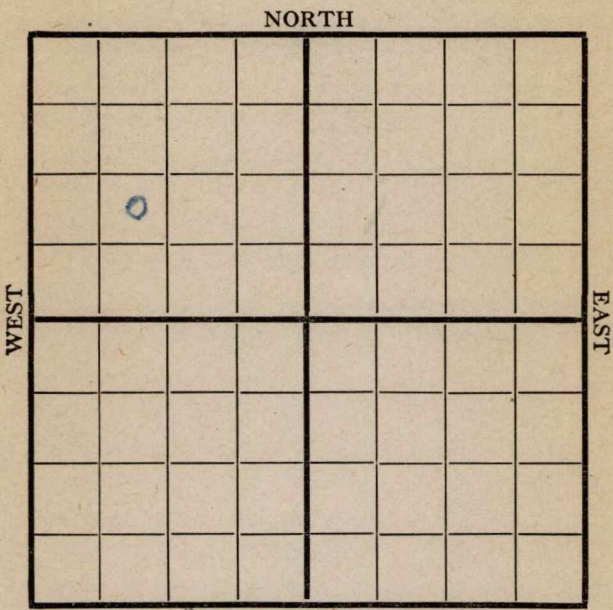

M.G.D. & J.M.

Location _____

Rig up _____

Drilling and Remarks:

Rigged up

RECORD

Cased _____ in., _____ ft.

Sand _____

Gas _____

Oil _____

Total Depth _____

PRODUCTION

1st 24 hrs. Nat. _____

1st 24 hrs. after shot _____

Gas _____ Cu. Ft.

Dry Hole _____

Abandoned _____

Date

Apr 8

Candy

191 _____

Scout

Map No. 1511 Sec. 20 Twp. 28 R. 4

Well No. 25 Smith

Argonne Company

Wentworth Bros Contractor

Argonne NORTH K-

WEST									

SOUTH

99059

Location _____

Rig up _____

Drilling and Remarks:

715

RECORD

Cased _____ in., _____ ft.

Sand _____

Gas _____

Oil _____

Total Depth _____

PRODUCTION

1st 24 hrs. Nat. _____

1st 24 hrs. after shot _____

Gas _____ Cu. Ft.

Dry Hole _____

Abandoned _____

Date

9/4

191

P. C. ...

Scout

Map No. N11 Sec. 20 Twp. 28 R. 4

Well No. 25 Smith


Empire Company

Contractor

NORTH

WEST

EAST

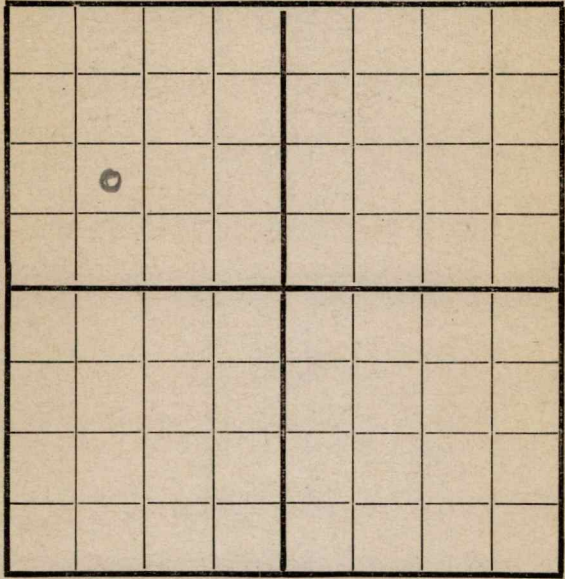

990 S & W SOUTH

Location _____

Rig up _____

Drilling and Remarks:

1235

RECORD

Cased _____ in., _____ ft.

Sand _____

Gas _____

Oil _____

Total Depth _____

PRODUCTION

1st 24 hrs. Nat. _____

1st 24 hrs. after shot _____

Gas _____ Cu. Ft.

Dry Hole _____

Abandoned _____

Date

9/11 1918 J. C. Cuddy Scout

Map No. 1511 Sec. 20 Twp. 28 R. 7

Well No. 25 Smith


Angine Company

Contractor

NORTH

WEST

EAST

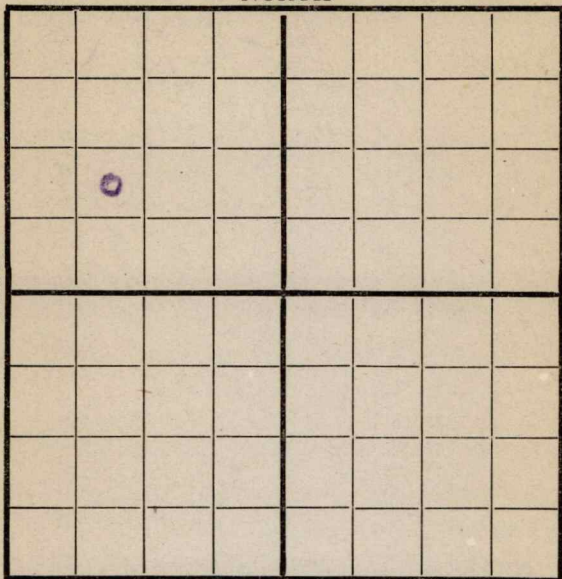

SOUTH

990 S & W

Location -----

Rig up -----

Drilling and Remarks:

1850

RECORD

Cased ----- in., ----- ft.

Sand -----

Gas -----

Oil -----

Total Depth -----

PRODUCTION

1st 24 hrs. Nat. -----

1st 24 hrs. after shot -----

Gas ----- Cu. Ft.

Dry Hole -----

Abandoned -----

Date

9/18

191

J. Carney

Scout


Map No. 1511 Sec. 20 Twp. 28 R. 4

Well No. 25 south

Engine Company

Contractor

NORTH

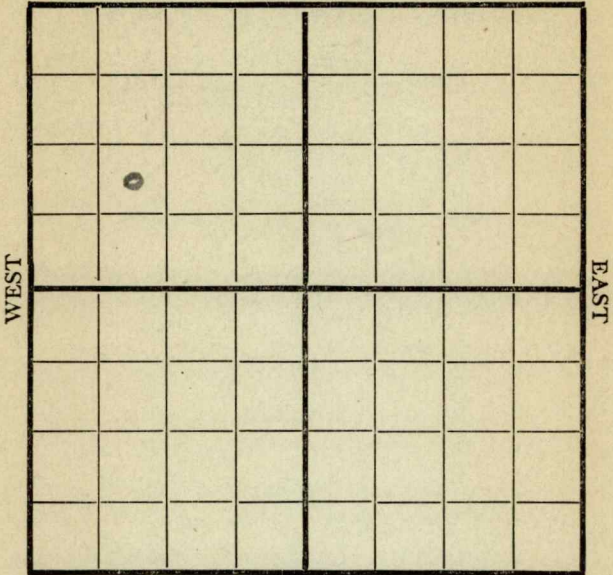

SOUTH

990 S-W

Location -----

Rig up -----

Drilling and Remarks:

2100

RECORD

Cased ----- in., ----- ft.

Sand -----

Gas -----

Oil -----

Total Depth -----

PRODUCTION

1st 24 hrs. Nat. -----

1st 24 hrs. after shot -----

Gas ----- Cu. Ft.

Dry Hole -----

Abandoned -----

Date


9/25 1911 S. Conroy Scout

Map No. 1511 Sec. 20 Twp. 28 R. 4

Well No. 25 Smith

Engage Company

Contractor

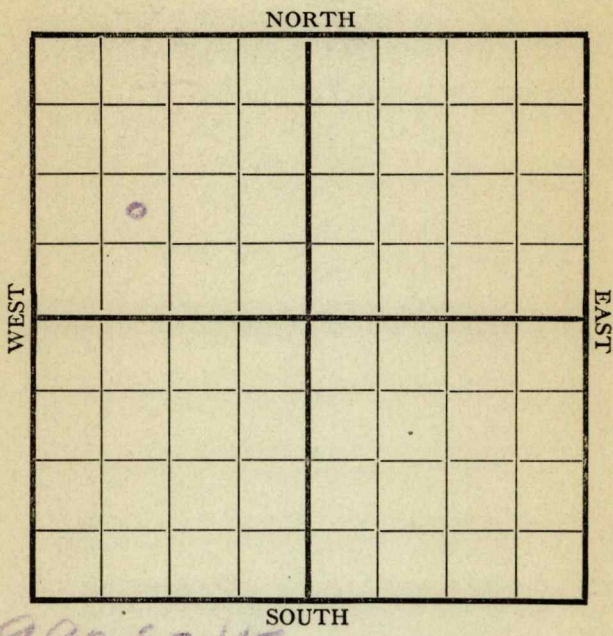

9905-W

Location -----

Rig up -----

Drilling and Remarks:

LD
2100

RECORD

Cased ----- in., ----- ft.

Sand -----

Gas -----

Oil -----

Total Depth -----

PRODUCTION

1st 24 hrs. Nat. -----

1st 24 hrs. after shot -----

Gas ----- Cu. Ft.

Dry Hole -----

Abandoned -----

Date

10/2 1911 J. Gandy

Scout


Map No. K11 Sec. 30 Twp. 38 R. 4

Well No. 25 Smith

Company Company

Contractor

NORTH

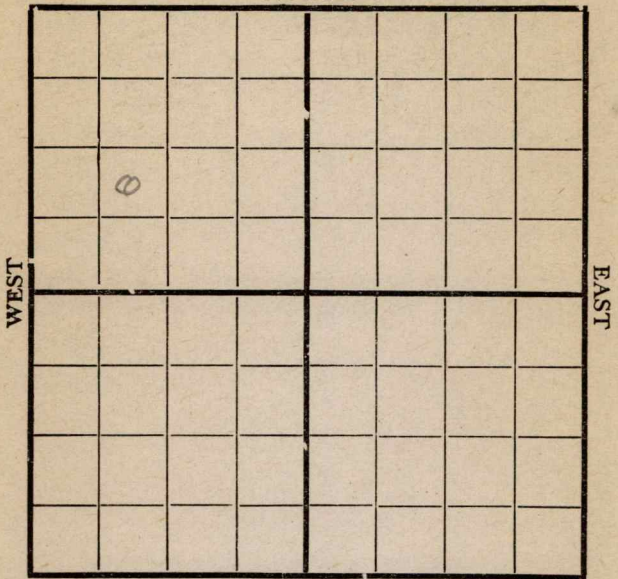

9903-W SOUTH

Location _____

Rig up _____

Drilling and Remarks:

223,00

RECORD

Cased _____ in., _____ ft.

Sand _____

Gas _____

Oil _____

Total Depth _____

PRODUCTION

1st 24 hrs. Nat. _____

1st 24 hrs. after shot _____

Gas _____ Cu. Ft.

Dry Hole _____

Abandoned _____

Date

10/9

191

Stanley

Scout


Map No. 511 Sec. 20 Twp. 28 R. 4

Well No. 25 Smith

Company Engine

Contractor _____

NORTH

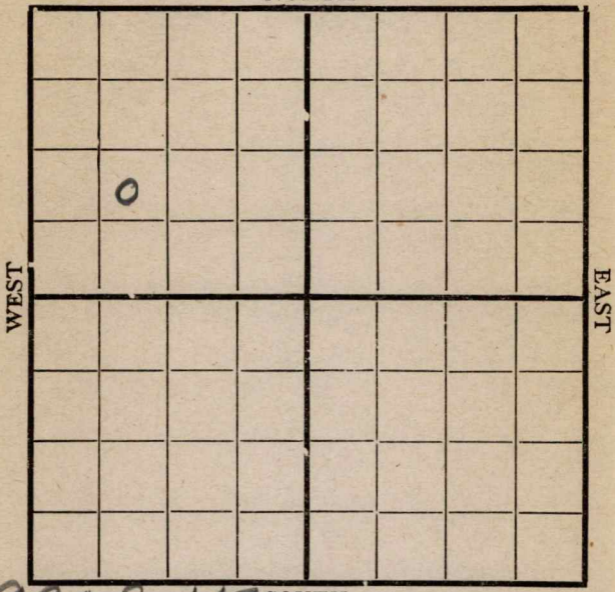

9905-W SOUTH

Location _____

Rig up _____

Drilling and Remarks:

2130

RECORD

Cased _____ in., _____ ft.

Sand _____

Gas _____

Oil _____

Total Depth _____

PRODUCTION

1st 24 hrs. Nat. _____

1st 24 hrs. after shot _____

Gas _____ Cu. Ft.

Dry Hole _____

Abandoned _____


Date

10/16 1918 S. Carey Scout

Map No. 1511 Sec. 20 Twp. 28 R. 4

Well No. 25 Smith
Empire Company
 Contractor

NORTH

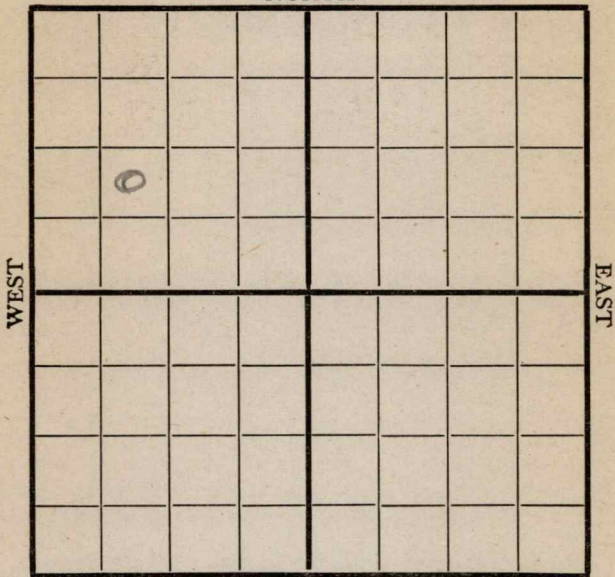

990 S-W SOUTH

Location -----

Rig up -----

Drilling and Remarks:

2350

RECORD

Cased ----- in., ----- ft.

Sand -----

Gas -----

Oil -----

Total Depth -----

PRODUCTION

1st 24 hrs. Nat. -----

1st 24 hrs. after shot -----

Gas ----- Cu. Ft.

Dry Hole -----

Abandoned -----

Date

10/30 1918 Empire Scott

Map No. 1511 Sec. 20 Twp. 28 R. 4

Well No. 25 Smith


Empire Company

Contractor

NORTH

WEST

EAST

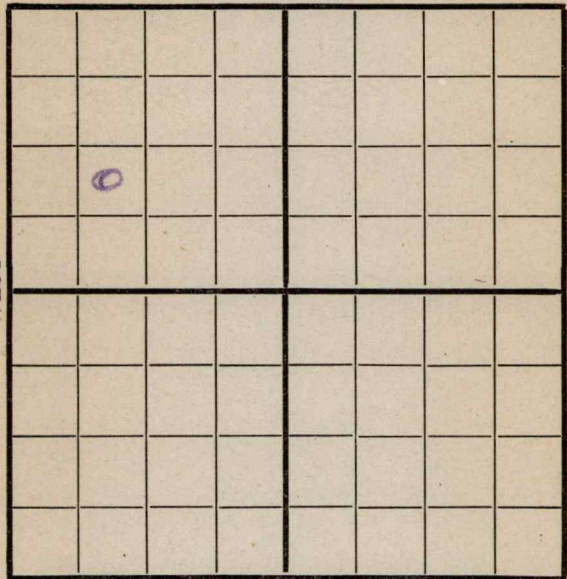

SOUTH

990 S-12

Location -----

Rig up -----

Drilling and Remarks:

2474

RECORD

Cased ----- in., ----- ft.

Sand -----

Gas -----

Oil -----

Total Depth -----

PRODUCTION

1st 24 hrs. Nat. -----

1st 24 hrs. after shot -----

Gas ----- Cu. Ft.

Dry Hole -----

Abandoned -----

Date

11/6

191

J. Carby

Scout


Map No. 111 Sec. 20 Twp. 28 R. 4

Well No. 25 Smith

Engine Company

Contractor

NORTH

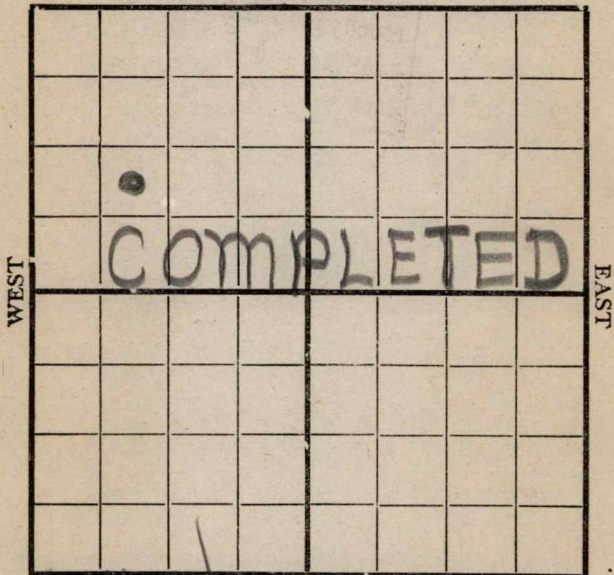

SOUTH

990 ft N

Location _____

Rig up _____

Drilling and Remarks:

got sand at
2474. drilled
bitche in
sand -
Estimated 160
Bbls.

RECORD

Cased _____ in., _____ ft.

Sand 2474 - 2474 1/2

Gas _____

Oil _____

Total Depth _____

PRODUCTION

1st 24 hrs. Nat. _____

1st 24 hrs. after shot _____

Gas _____ Cu. Ft.

Dry Hole _____

Abandoned _____

Date

1/14 191 P. Conroy Scout