


Section 35 Township 30 Range 4 E

Well No. # 1 Hanlen

Company Schio Oil

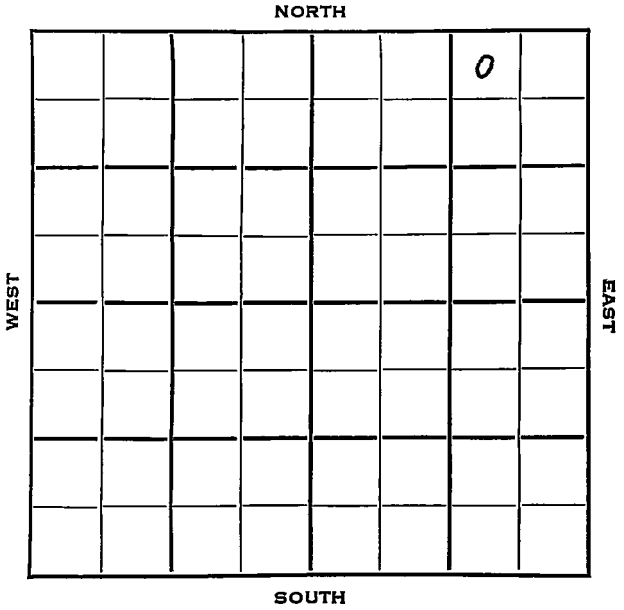


Sec. 35 Twp. 30 R. 1EWell No. 4 Hanlen FarmSohio Oil CompanyWakefield ContractorDavid Pool330 Ft. from N. Line

Ft. from S. Line

990 Ft. from E. Line

Ft. from W. Line

NW NE NE

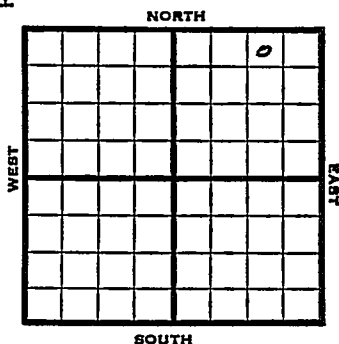

1953 Elev. 1320' REPORT

4/15 Location

5/13 Spud 4-16-53

D &amp; A TD 3007 8" @ 139 Stal. 1980

Layton 2168 KC 2348 B KC 2576

Oswego 2773 Peru 2804' RF sd 2891'

Bart. sd 2930

DST 2891-2902 open 1 hr rec 3' mud Off

TD 2975 5" @ 2955 CO to 2975

sd-frac. B/1/2 BOPH 34 qt/2957-74

CO to 2973 B/6 1/2 GOPH 1/2 GW DD 3007

Miss ch 3001'

D &amp; A

**ABANDONED**



