


Cowley **KANSAS**

SECTION 36 TOWNSHIP 30 RANGE 4E

WELL NO. #1 Rodgers

COMPANY E.F. Wakefield

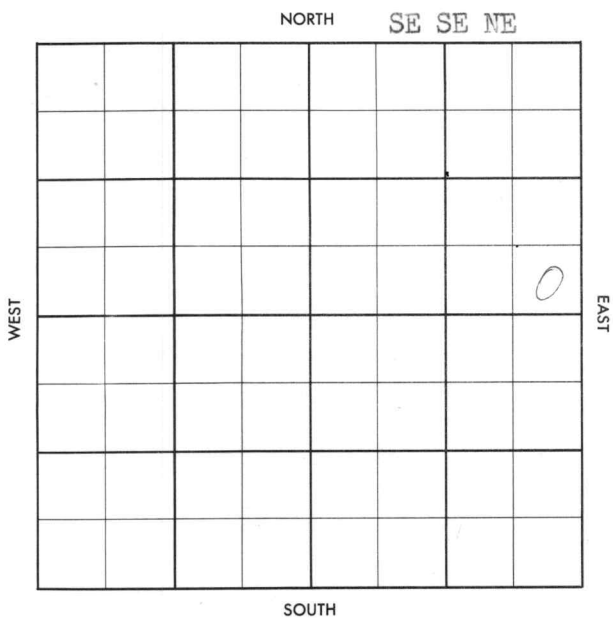

WILDCAT

FORM 513 SUNRAY

County Cowley Elev. 1293
Sec. 36 Twp. 30 Rge. 4 E
Company E. F. Wakefield
Farm Name Rodgers No. 1

TOPS	DEPTH	LOG	DATUM	Loc. in Sec.						
Anh.				SE SE NE						
Tr.										
Dg. <u>Stal.</u>	<u>1960</u>									
BL.										
L.				Geol.						
K.C.	<u>2246</u>			Contr.						
B.K.C.										
Ce.										
C. <u>Ieve.</u>	<u>2553</u>			Co. tools						
M.				Pool						
M. <u>Oswego</u>	<u>2724</u>									
K.										
Mz. <u>Peru</u>	<u>2743</u>			Wildcat						
V. <u>Bart.</u>	<u>2900</u>			<table border="1"><tr><td colspan="2">FIRST REPORT</td></tr><tr><td></td><td></td></tr><tr><td colspan="2">JAN 23 '57</td></tr></table>	FIRST REPORT				JAN 23 '57	
FIRST REPORT										
JAN 23 '57										
S.										
S.										
A.										
R.										
Pe.										
G.										
T.D.										

Date Comm. 1-18-57

8" @ 125/125 drlg. 2947

29

County Cowley Elev. 1293
 Sec. 36 Twp. 30 Rge. 1 E
 Company W. F. Wakefield
 Farm Name Rodgers No. 1

TOPS	DEPTH	LOG	DATUM
Anh.			
Tr.			
H.			
Tr.			
Dg. <u>stal.</u>	<u>1960</u>		
BL.			
L.			
K.C.	<u>2216</u>		
B.K.C.			
Ce.			
C. <u>leve.</u>	<u>2553</u>		
M.			
M. <u>Oswego</u>	<u>2724</u>		
K.			
Mz. <u>Porn</u>	<u>2713</u>		
Ms.			
V. <u>Hart.</u>	<u>2000</u>		
S. <u>MISS</u>	<u>2960</u>		
S.			
A.			
R.			
PE.			
G.			
T.D.	<u>3010</u>		

Loc. in Sec. SE SE NE
 Geol. _____
 Contr. Co. tools
 Pool _____
Wildcat
ABANDONED
 JAN 30 '57

Date Comm. 7-18-57

8" @ 125/125 drl. 2917 JAN 30 '57

DEA

Co.

Lse.

No.

Sec.

T.

R.