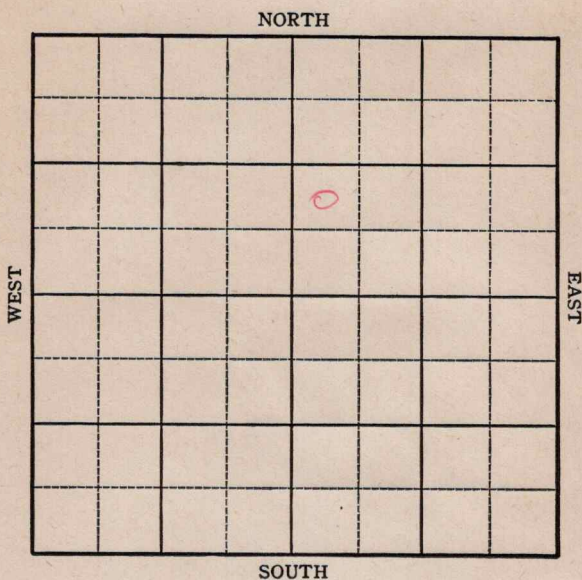


KANSAS

Russell

Section 28 Township 13 Range 14WWell No. #1 2 Killian "B"Company V. D. Sidey

KANSAS

Russell


Sec. 28 Twp. 13 R. 14-W
Well No. #2 Killian "B" Farm
V. D. Sidey Company

 Ft. from N. Line

990 Ft. from S. Line

 Ft. from E. Line

330 Ft. from W. Line

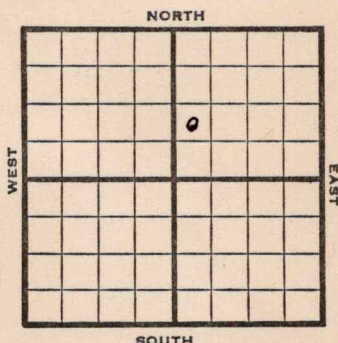

NW SW NE

1945

Elev. 1847

REPORT

11/7

Location
Rig

11/14

15" @ 280
Drlg. 290'

11/21

Anhy. 882
Drlg. 950'

11/28

12" @ 525
10" @ 883
Drlg. 2110'

12/5

8" @ 2470
Drlg. 2700

12/12

Lans 3000
6" @ 3000
Drlg. 3075

12/20

S.O. 3167-69' 3175' H.R. 6"

12/29

" " "

1946

1/10

T.D. 3268' No Arb top.
Pumping.

1/17

"

1/23

Arb. 3265
5" @ 3265
TD 3268
Pump 100 Pot.
Grav. 33.0

COMPLETED

Pool Name Russell

72 Kansas
 Map No. KANSAS Sec. 28 Twp. 13 R. 14W

Well No. 2 Killian

V. D. Sidey Company

CORRECTION Contractor

NW SW NE

SECTION PLAT

		o	

 Ft. from N. Line

990
 Ft. from S. Line

 Ft. from E. Line

330
 Ft. from W. Line

RussellLocation Rig up

Drilling and Remarks:

Had foot
 measurements wrong

RECORD

Cased in., ft.Sand Gas Oil Total Depth

PRODUCTION

1st 24 hrs. Nat. 1st 24 hrs. after shot Gas Cu. Ft.Dry Hole Abandoned


Date

NOV 7 1945 19 S. J. LEWIS Scout

KANSASKansas Pool Name RussellMap No. _____ Sec. 28 Twp. 13 R. 14WWell No. 2 KillianV.D. Sidey CompanyFIRST REPORT Contractor

NW SW NE

SECTION PLAT

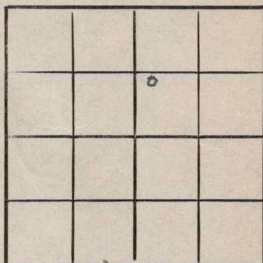330 Ft. from N. Line

_____ Ft. from S. Line

_____ Ft. from E. Line

330 Ft. from W. LineRussell County

Location _____

Rig up _____

Drilling and Remarks:
rig

RECORD

Cased _____ in., _____ ft.

Sand _____

Gas _____

Oil _____

Total Depth _____

PRODUCTION

1st 24 hrs. Nat. _____

1st 24 hrs. after shot _____

Gas _____ Cu. Ft.

Dry Hole _____

Abandoned _____

Date

NOV 7 1945 19 S. J. LEWIS Scout

KANSASKansas Pool Name RussellMap No. K-72 Sec. 28 Twp. 13 R. 14WWell No. 1 Killian "B"V.D. Sidey

Company

CORRECTION

Contractor

NW SW NE

SECTION PLAT

		0	

Ft. from N. Line990 Ft. from S. LineFt. from E. Line330 Ft. from W. LineRussell

Location

Rig up

Drilling and Remarks:

reported as

#2 Killian

*convert from
#2 to #1*

RECORD

Cased _____ in., _____ ft.

Sand _____

Gas _____

Oil _____

Total Depth _____

PRODUCTION

1st 24 hrs. Nat. _____

1st 24 hrs. after shot _____

Gas _____ Cu. Ft.

Dry Hole _____

Abandoned _____

Date

DEC 1 9 1945


19

S. J. LEWIS

Scout

732188

check Feet measure-
ments and spot
advis
Sam

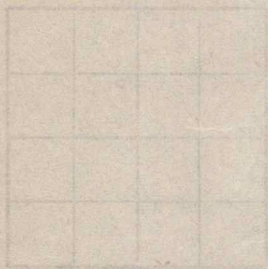

Misc Small Maps	
Cards	<i>Skat</i>
Tracing	<i>RB</i>
France Map	
Scarborough Map	
Pierce Map	
Geological Dept.	
Pierce Plat Book	

KANSAS

Kansas

Pool Name RussellMap No. 72 Sec. 28 Twp. 13 R. 14WWell No. 1 Killian "B"V. D. Sidey

Company

COMPLETED

Contractor

NW SW NE

E1.1847
SECTION PLAT

		4	

Ft. from N. Line990 Ft. from S. LineFt. from E. Line330 Ft. from W. Line

Russell County

Location

Rig up

Drilling and Remarks:

Art 82655" @ 8265Pump 100 BT33° E**RECORD**

Cased _____ in., _____ ft.

Sand _____

Gas _____

Oil _____

Total Depth 3265**PRODUCTION**

1st 24 hrs. Nat. _____

1st 24 hrs. after shot _____

Gas _____ Cu. Ft.

Dry Hole _____

Abandoned _____

Date

JAN 23 1946 19S. J. LEWIS

Scout