


Map No. _____ Sec. 26 Twp. 28 R. 4Well No. 69 J. W. Smith Farm _____Empire Company _____

NORTH

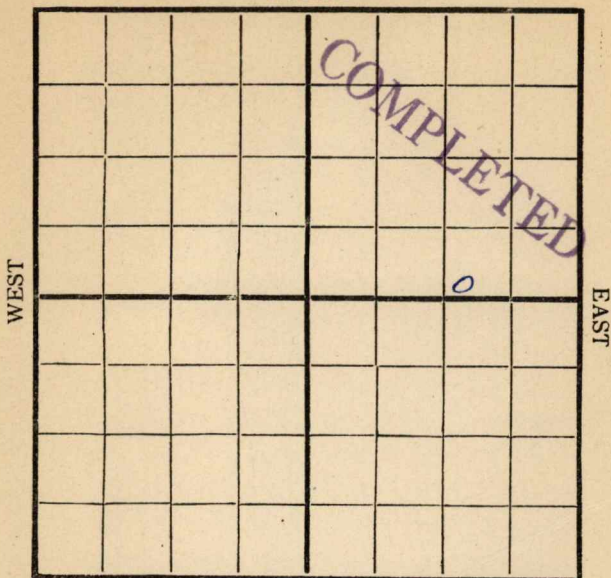

SOUTH

Location _____

Rig Up _____

Drilling Remarks:

6/30 fishing

Drilling Remarks:

RECORD

Cased _____ in _____ Ft.

Sand _____

Gas _____

Oil _____

Total Depth _____

PRODUCTION

1st 24 hrs. Nat. _____

1st 24 hrs. after shot _____

Gas _____ Cu. Ft.

Dry Hole _____

Abandoned _____

Map No. _____ Sec. 20 Twp. 28 R. 4
 Well No. Q. J. W. Smith Farm _____
Wichita or Empire Company _____
KGS/ONE

NORTH

WEST

EAST

SOUTH

Location _____

Rig Up _____

Drilling and remarks

6/30 fishing

RECORD

Cased _____ in. _____ Ft.

Sand _____

Gas _____

Oil _____

Total Depth _____

PRODUCTION

1st 24 hrs. Nat. _____

1st 24 hrs. after shot _____

Gas _____ Cu. Ft.

Dry Hole _____

Abandoned _____

Date

6/30, 1916, McCandless Scout

Map No. _____ Sec. *on* Twp. *28* R. *4*
 Well No. *6* *W* *Smith* Farm
Empire Company

NORTH

WEST

EAST

SOUTH

Location _____

Rig Up _____

Drilling and remarks
670

RECORD

Cased _____ in. _____ Ft.

Sand _____

Gas _____

Oil _____

Total Depth _____

PRODUCTION

1st 24 hrs. Nat. _____

1st 24 hrs. after shot _____

Gas _____ Cu. Ft.

Dry Hole _____

Abandoned _____


Date

7/10, 191 *5* *L. C. Smith* Scout

Map No. _____ Sec. 20 Twp. 28 R. 4
 Well No. 6 Smith Farm _____
Empire Company _____

NORTH

WEST

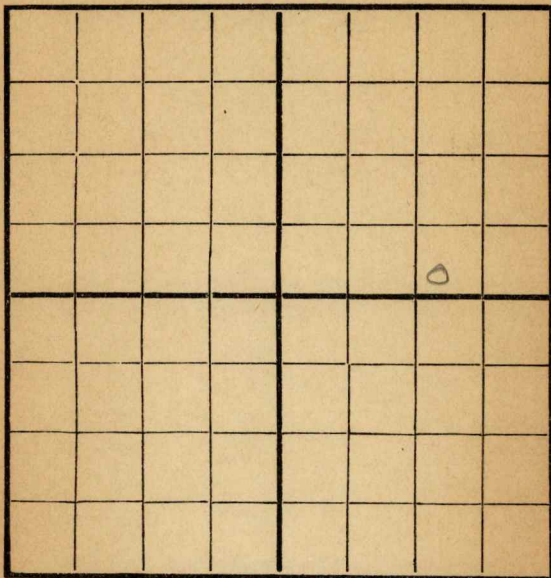

EAST

SOUTH

Location _____
 Rig Up _____
 Drilling and remarks _____

RECORD

Cased _____ in. _____ Ft.
 Sand _____
 Gas _____
 Oil _____
 Total Depth _____

PRODUCTION

1st 24 hrs. Nat. _____
 1st 24 hrs. after shot _____
 Gas _____ Cu. Ft.
 Dry Hole _____
 Abandoned _____


Date

7/21, 1916 Scout

Map No. _____ Sec. 20 Twp. 28 R. 4
 Well No. 6 _____ Farm _____
 _____ Company _____

NORTH

WEST

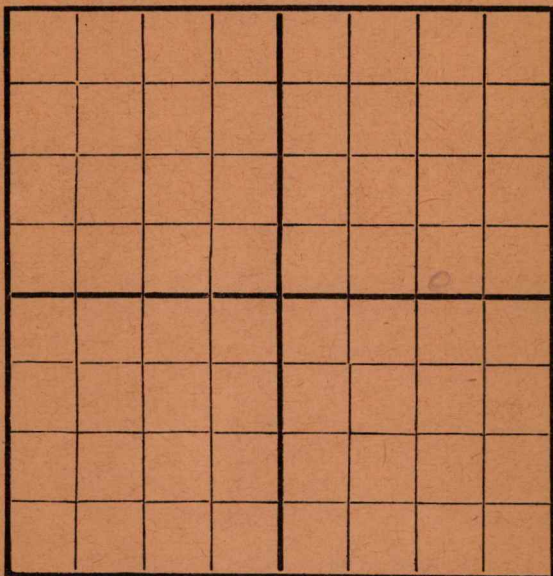

EAST

SOUTH

Location _____
 Rig Up _____
 Drilling and remarks _____

1600'

RECORD

Cased _____ in. _____ Ft.
 Sand _____
 Gas _____
 Oil _____
 Total Depth _____

PRODUCTION

1st 24 hrs. Nat. _____
 1st 24 hrs. after shot _____
 Gas _____ Cu. Ft.
 Dry Hole _____
 Abandoned _____


Date

7/25 1916 Ray Scout

Map No. _____ Sec. 30 Twp. 28 R. 4
 Well No. 6 Smith Farm _____
Empire Company _____

NORTH

WEST

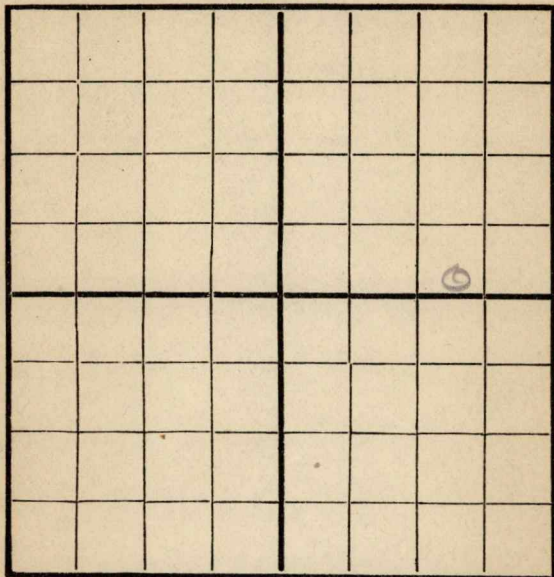

EAST

SOUTH

Location _____
 Rig Up _____
 Drilling and remarks _____

RECORD

Cased _____ in. _____ Ft.
 Sand _____
 Gas _____
 Oil _____
 Total Depth _____

PRODUCTION

1st 24 hrs. Nat. _____
 1st 24 hrs. after shot _____
 Gas _____ Cu. Ft.
 Dry Hole _____
 Abandoned _____


Date

7/31, 1916 Leeby Scout

1722
Casing
with 8 1/4"

Map No. _____ Sec. 20 Twp. 28 R. 4
 Well No. 6 Smith Farm _____
Angus Company _____

NORTH

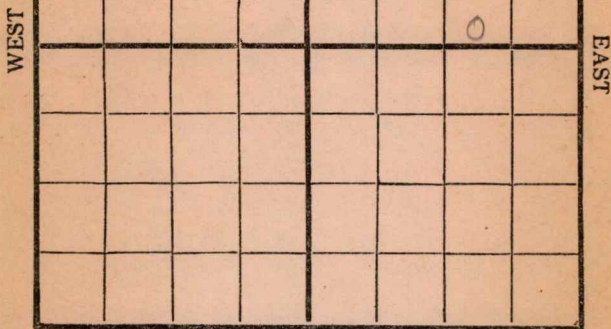

SOUTH

Location _____
 Rig Up _____
 Drilling and remarks

1265
Under running

RECORD

Cased _____ in. _____ Ft.
 Sand _____
 Gas _____
 Oil _____
 Total Depth _____

PRODUCTION

1st 24 hrs. Nat. _____
 1st 24 hrs. after shot _____
 Gas _____ Cu. Ft.
 Dry Hole _____
 Abandoned _____

Date


8/8, 1916 6 McCandless Sec. _____

Map No. _____ Sec. 20 Twp. 28 R. 4
 Well No. 6 Smith Farm _____
Engine Company _____

NORTH

WEST

EAST

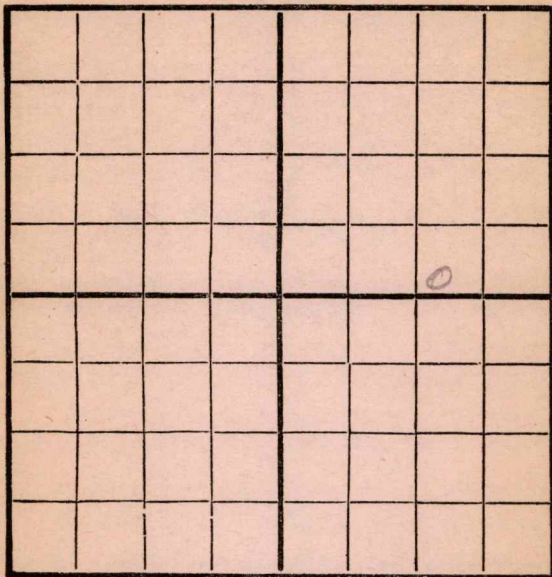

SOUTH

Location _____
 Rig Up _____
 Drilling and remarks _____

1950

RECORD

Cased _____ in. _____ Ft.
 Sand _____
 Gas _____
 Oil _____
 Total Depth _____

PRODUCTION


1st 24 hrs. Nat. _____
 First 24 hrs. after shot _____
 Gas _____ Cu. Ft.
 Dry Hole _____
 Abandoned _____

Date

8/15, 1916 L. P. Smith Scout

Map No. _____ Sec. 20 Twp. 28 R. 4
 Well No. 6 Smith Far _____
Company _____ Company _____

NORTH

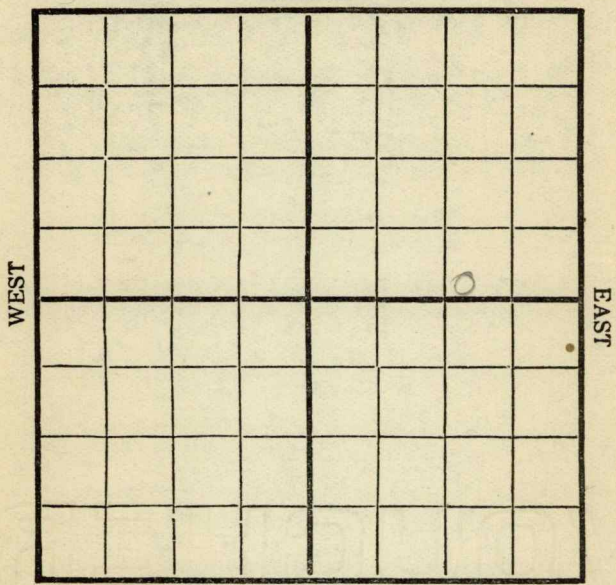

SOUTH

Location _____
 Rig Up _____
 Drilling and remarks
1935

RECORD

Cased _____ in. _____ Ft.
 Sand _____
 Gas _____
 Oil _____
 Total Depth _____

PRODUCTION

1st 24 hrs. Nat. _____
 First 24 h. s. after shot _____
 Gas _____ Cu. Ft.
 Dry Hole _____
 Abandoned _____

Date 8/24 1916 LCC Scout

Map No. _____ Sec. 20 Twp. 28 R. 4Well No. 6 Smith Farm _____Empire Company _____

NORTH

WEST

EAST

SOUTH

Location _____

Rig Up _____

Drilling and remarks

2100

RECORD

Cased _____ in. _____ Ft.

Sand _____

Gas _____

Oil _____

Total Depth _____

PRODUCTION

1st 24 hrs. Nat. _____

1st 24 hrs. after shot _____

Gas _____ Cu. Ft.

Dry Hole _____

Abandoned _____

Date

191


Scout

AUG 30 1916

Map No. _____ Sec. 20 Twp. 28 R. 9Well No. 6 Smith Farm _____6 Empire Company _____

NORTH

WEST

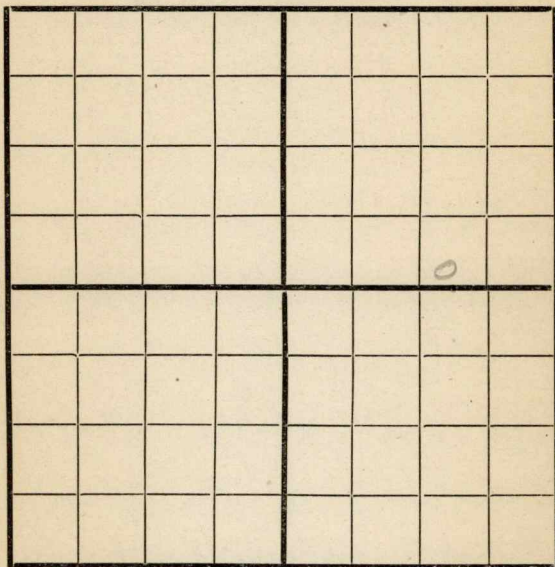

EAST

SOUTH

Location _____

Rig Up _____

Drilling and remarks

2310

RECORD

Cased _____ in. _____ Ft.

Sand _____

Gas _____

Oil _____

Total Depth _____

PRODUCTION

1st 24 hrs. Nat. _____

1st 24 hrs. after shot _____

Gas _____ Cu. Ft.

Dry Hole _____


Abandoned _____

Date

9/4, 1916 L. R. R. R. Scout

Map No. _____ Sec. 20 Twp. 28 R. 4
 Well No. 6 Smith Farm _____
Empire Company _____

NORTH

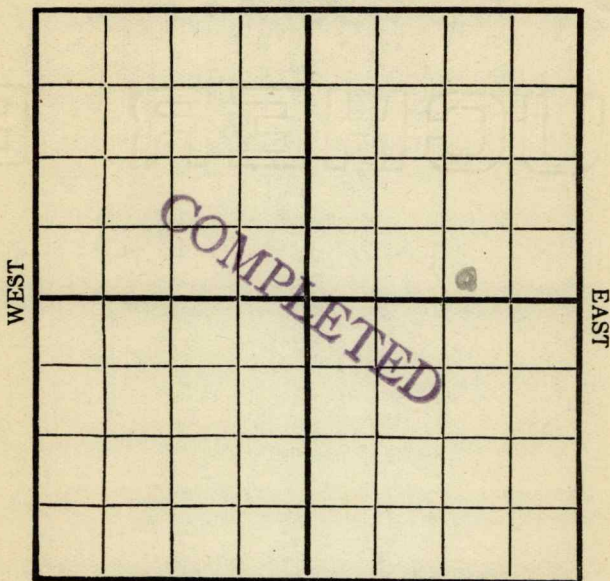

SOUTH

Location _____
 Rig Up _____
 Drilling and remarks _____

*Estimated
 prod for
 250 bbls*

RECORD

Cased _____ in. _____ Ft.
 Sand _____
 Gas _____
 Oil _____
 Total Depth _____

PRODUCTION

1st 24 hrs. Nat. _____
 1st 24 hrs. after shot _____
 Gas _____ Cu. Ft.
 Dry Hole _____
 Abandoned _____

Date 9/12, 1916 B. B. Carey Scout