


Map No. _____ Sec. 20 Twp. 28 R. 4
 Well No. 33 Smith Farm
Empire Company

NORTH

WEST

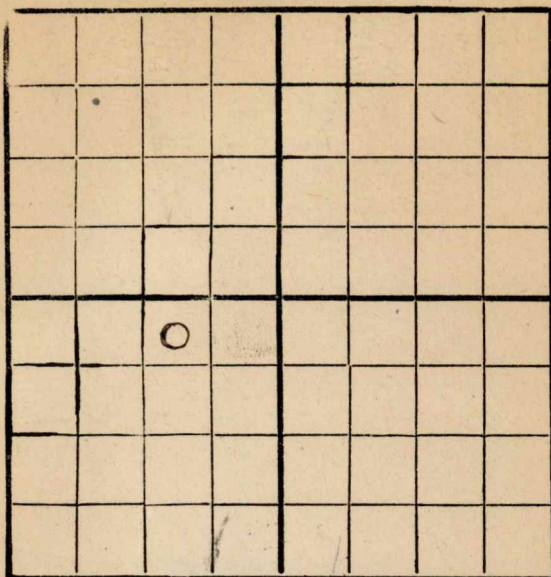

EAST

SOUTH

Location _____

Rig Up _____

Drilling Remarks:

Drilling Remarks:

RECORD

PRODUCTION

Cased _____ in. _____ ft.

1st 24 hrs. Nat. _____

Sand _____

1st 24 hrs. after shot _____

Gas _____

Gas _____ cu. ft.

Oil _____

Dry Hole _____

Total Depth _____

Abandoned _____

Map No. K11 Sec. 20 Twp. 28 R. 4

Well No. 33 Smith

Empire Company

Contractor

NORTH

WEST

EAST

FIRST REPORT

990 E

SOUTH

330 N

Location _____

Cased_____in., _____ft.

Rig up.....

Sand _____

Drilling and Remarks:

Gas _____

Oil _____

Total Depth_____

RECORD

PRODUCTION

1st 24 hrs. Nat.

1st 24 hrs. after shot-----

Gas.....Cu. Ft.

Dry Hole.....

Abandoned.....

Date _____

Date 7/18 1919 Pay Scout

Scout

Map No. K11 Sec. 20 Twp. 28 R. 4Well No. 33 SmithEmpire Company

Contractor

SECTION PLAT

330 Ft. from N. Line

Ft. from S. Line

990 Ft. from E. Line

Ft. from W. Line

Location

Rig up

Drilling and Remarks:

10 bbls oil25 bbls water1st 24 hrs

RECORD

Cased _____ in., _____ ft.

Sand 2445 - 2464

Gas _____

Oil _____

Total Depth _____

PRODUCTION

1st 24 hrs. Nat. _____

1st 24 hrs. after shot _____

Gas _____ Cu. Ft.

Dry Hole _____

Abandoned _____

Date

10/4 1919

Pyle

Scout