

KANSAS


Russell county

FORM 51 5M 6-46 PETROL

Section 28 Township 13 Range 14-W

Well No. #3, Killian

Company D. V. Sidey

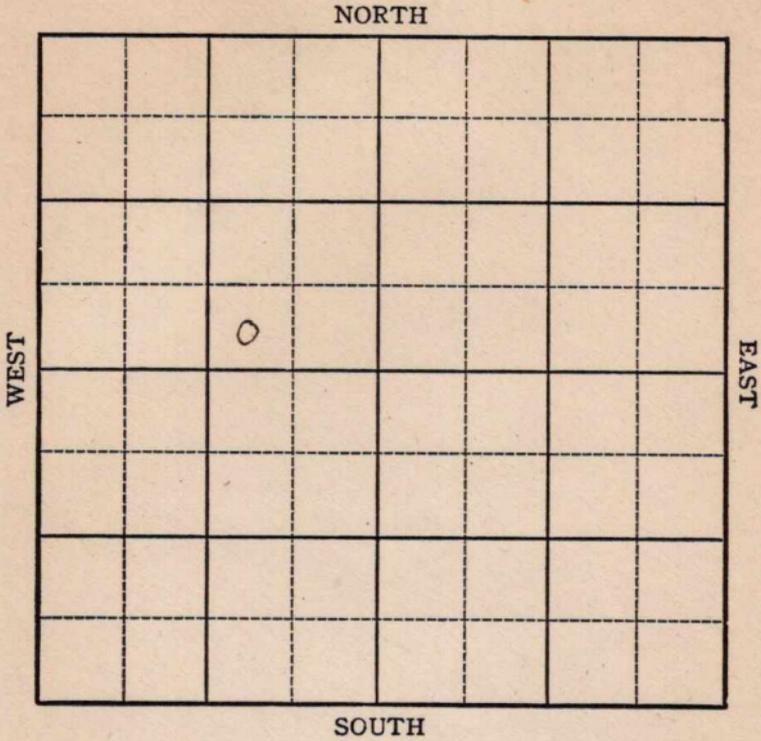

Sec. 28 Twp. 13 R. 14W

Well No. #3 Killian Farm

D.V. Sidey Company


Russell

Ft. from N. Line

330 Ft. from S. Line

860 Ft. from E. Line

Ft. from W. Line

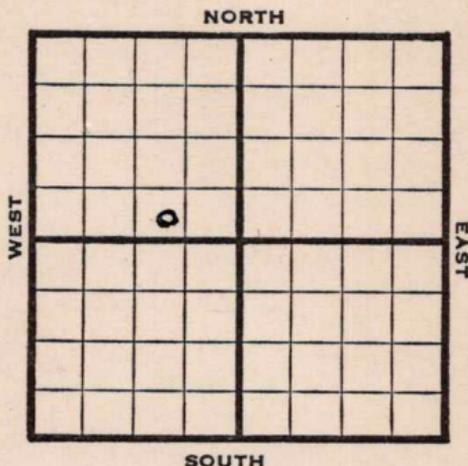

SW SE NW

1946

Elev. 1853' REPORT

9/25 Location

10/1 Rig

10/8 "

10/15 "

10/22 "

10/29 Spud

11/6 15" @ 288'

12" @ 520'

Anhy 890'

10" @ 892'

Drlg 1075'

11/12 Drlg 1800'

11/20 8" @ 2465'

Topeka 2705'

Drlg 2730'

11/27 Lans 3008'

Drlg 3100'

12/3 5" @ 3260', Drlg

12/10 SD

12/17 "

1947

1/4 SD

OVER

732200

1947

1/8

Arb 3278'

5" @ 3278'

TD 2283'

Pump 100 Pot

34 Grav.

**COMPLETED**

**KANSAS**

Kansas Pool Name Russell

Map No. 72 Sec. 28 Twp. 13 R. 14W

Well No. 3 Killian

D. V. Sidey Company

**FIRST REPORT** Contractor

SW SE NW

**SECTION PLAT**

	0		

       Ft. from N. Line

330 Ft. from S. Line

860 Ft. from E. Line

       Ft. from W. Line

Russell County

Location X

Rig up       

Drilling and Remarks:

**RECORD**

Cased        in.,        ft.

Sand       

Gas       

Oil       

Total Depth       

**PRODUCTION**

1st 24 hrs. Nat.       

1st 24 hrs. after shot       

Gas        Cu. Ft.

Dry Hole       

Abandoned       

Date

SEP 25 1946 19

S. J. LEWIS Scout

ANS 33

Map No. 72 Sec. 28 Twp. 13 R. 14W

Well No. 3 Killian

D. V. Sidey Company

COMPLETE Contractor

SW SE NW

*21.1853*

SECTION PLAT


\_\_\_\_\_ Ft. from N. Line

330 Ft. from S. Line

860 Ft. from E. Line

\_\_\_\_\_ Ft. from W. Line

Russell County

Location \_\_\_\_\_

Rig up \_\_\_\_\_

Drilling and Remarks:

*Cr 8278*

*5" @ 8278*

*Pump 100 P.D.*

*34 3/4*

RECORD

Cased \_\_\_\_\_ in., \_\_\_\_\_ ft.

Sand \_\_\_\_\_

Gas \_\_\_\_\_

Oil \_\_\_\_\_

Total Depth 2283

PRODUCTION

1st 24 hrs. Nat. \_\_\_\_\_

1st 24 hrs. after shot \_\_\_\_\_

Gas \_\_\_\_\_ Cu. Ft.

Dry Hole \_\_\_\_\_

Abandoned \_\_\_\_\_

Date

JAN 8 1947 19

S. J. LEWIS Scout