


Section 28 Township 13 ~~14~~ Range 14 W

Well No. #5 Killion "A"

Company V. D. Sidey

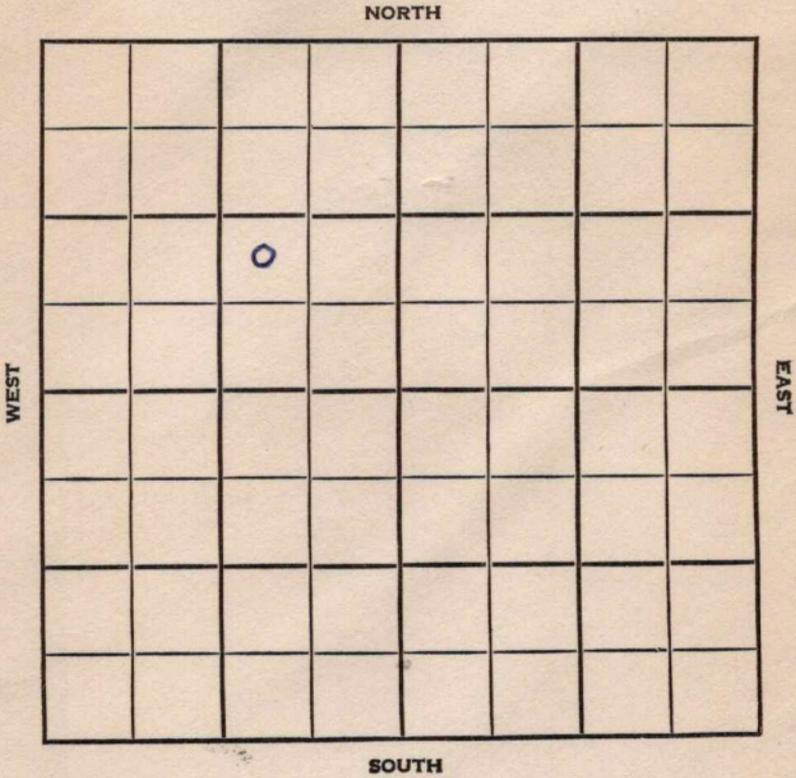

Russell

KANSAS

SEC. 28	TWP. 14 ¹³	R. 14W
------------	--------------------------	-----------

WELL NO.

#5 Killion "A"

FARM

COMPANY

V.D. Sidey

CONTRACTOR

Co. Tools


Russell

_____ Ft. from N. Line

_____ Ft. from S. Line

_____ Ft. from E. Line

_____ Ft. from W. Line

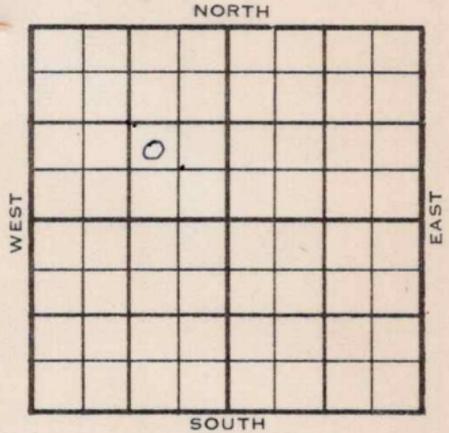

NW SE NW

1956 # 1851'	ELEVATION	REPORT
--------------	-----------	--------

3-14 RUR

5-9
 Comm. 3-12-56
 8 5/8" @ 120 w/100
 5 1/2" @ 3271
 DD 3274, 500 A
 FU 2500' fluid,
 Comp. 25 bopd, 95% wtr.
 H. 2946', L. 3003', A. 3267',
 TD 3272'

COMPLETED

County Russell Elev. _____
 Sec. 28 Twp. 14 Rge. 14W
 Company V. D. Sidey
 Farm Name Killion "A" No. 5


TOPS	DEPTH	LOG	DATUM
Anh.			
TP.			
H.			
Tr.			
Dg.			
Bl.			
L.			
K.C.			
B.K.C.			
Ce.			
C.			
M.			
M.			
K.			
Mz.			
Mq.			
V.			
S.			
S.			
A.			
R.			
PE.			
G.			
T.D.			

Loc. in Sec. NW SE NW

Geol. _____

Contr. Co. tools


Pool Russell

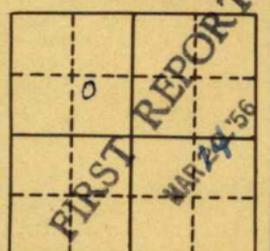

MAR 14 1956

Date Comm. RUR

Co.
Lse.
No.
Sec.
T.
R.

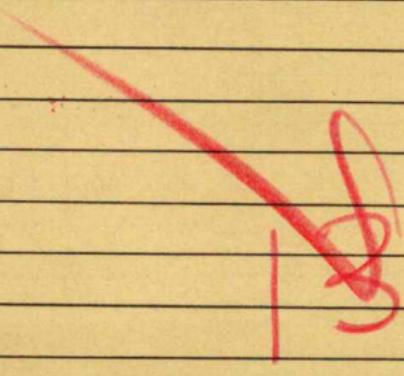

CORRECTION

FORM 513 REV. SUNRAY

County Russell Elev. _____

Sec. 28 Twp. 13 Rge. 11W

Company V. D. Sidey

Farm Name Killion "A" No. 5

TOPS	DEPTH	LOG	DATUM
Anh.			
Tp.			
H.			
Tr.			
Dg.			
Bl.			
L.			
K.C.			
B.K.C.			
Ce.			
C.			
M.			
M.			
K.			
Mz.			
Mq.			
V.			
S.			
S.			
A.			
R.			
Pe.			
G.			
T.D.			

Loc. in Sec. _____

NW SE NW

Geol. _____

Contr. _____

Pool _____



CORRECTION

Date Comm. Reported 28-11-11W MAY 9 1956

Co.
Lse.
No.
Sec.
T.
R.

County Russell Elev. 1851
 Sec. 28 Twp. 13 Rge. 14W
 Company V. D. Sidey
 Farm Name Killion "A" No. 5

TOPS	DEPTH	LOG	DATUM	Loc. in Sec.									
Anh.				NW SE NW									
Tr.													
H.	<u>2946</u>												
Dg.													
Bl.													
L.	<u>3003</u>		<u>1152</u>	Geol.									
K.C.				Contr.									
B.K.C.				Co. tools									
Ce.													
C.				Pool									
M.				Russell									
Mz.				<table border="1"> <tr><td></td><td></td><td></td></tr> <tr><td></td><td>o</td><td></td></tr> <tr><td></td><td></td><td></td></tr> </table>					o				
	o												
Mq.													
V.													
S.													
A.	<u>3267</u>		<u>1416</u>										
R.													
Pf.													
G.													
T.D.	<u>3272</u>			COMPLETE									

Date Comm. 3-12-56 MAY 9 1956

8 5/8" @ 120/100 5 1/2" @ 3271

DD 3274 500 A FU 2500' fluid

Comp. 25 bopd 95% wtr.