


Section.....25.....Township.....15.....Range.....14-W

Well Number...#5 Mollie.....

Company.....Gulf.....

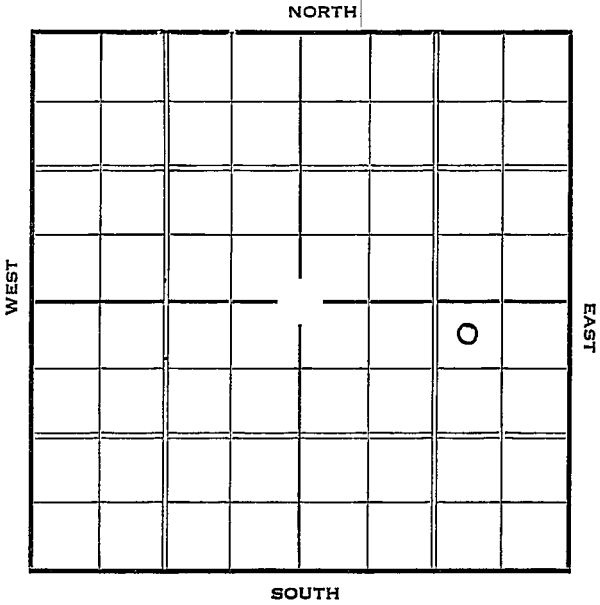

Sec. 25 Twp. 15 R. 14-7

Well No. #5 Mollie Farm


Gulf Company

330 Ft. from N. Line

_____ Ft. from S. Line

990 Ft. from E. Line

_____ Ft. from W. Line

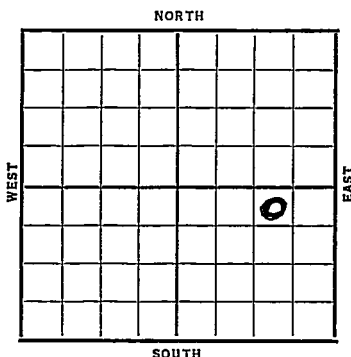

Date	REPORT
1937	
7/21	Rig
7/30	10" @ 570'. WOC.
8/6	Drlg. 2840'.
8/13	Sil. & 7" @ 3321'.
	T.D. 3323'. RUST.
8/20	T.D. 3325'. 250' oil. 5 hrs.
	2000 acid.
	Pumped 489 oil 8 hrs. S.W.
8/25	7" @ 3321'
	Sil 3321'
	TD 3325'
	2000 acid
	Pump 299.98/4 - 6% water
	288.66/4 - 10% water
	Pot 1732
	COMPLETED

Russell

Map No. 73 Sec. 25 Twp. 15 R. 14W

Well No. 5- Mollie

Gulf Company
Contractor

FIRST REPORT

SECTION PLAT

330 Ft. from N. Line
 _____ Ft. from S. Line
990 Ft. from E. Line
 _____ Ft. from W. Line

			0

Location _____

Rig up _____

Drilling and Remarks:

Rig

RECORD

Cased _____ in., _____ ft.
 Sand _____
 Gas _____
 Oil _____
 Total Depth _____

PRODUCTION

1st 24 hrs. Nat. _____
 1st 24 hrs. after shot _____
 Gas _____ Cu. Ft.
 Dry Hole _____
 Abandoned _____

Date

JUL 21 1937
19

H. D. Hatfield Scout

Russell KANSAS

Map No. _____ Sec. 25 Twp. 15 R. 14^WWell No. 5-MollieGulf Company

Contractor _____

COMPLETED

SECTION PLAT

			0

330 Ft. from N. Line

_____ Ft. from S. Line

990 Ft. from E. Line

_____ Ft. from W. Line

Location _____

Rig up _____

Drilling and Remarks:

2000 AcidPump 299.98/4288.66/4Pot - 17.32

RECORD

Cased 7 in., 3321 ft.Sand S11 3321

Gas _____

Oil _____

Total Depth 3325

PRODUCTION

1st 24 hrs. Nat. _____

1st 24 hrs. after shot _____

Gas 19% water _____ .Cu. Ft.

Dry Hole _____

Abandoned _____

Date

AUG 25 1919H. D. Hatfield Scout