


Section 21 Township 28 Range 4E

Well No. #1 Blood

Company Aikman & Braden

Miscellaneous

NORTH

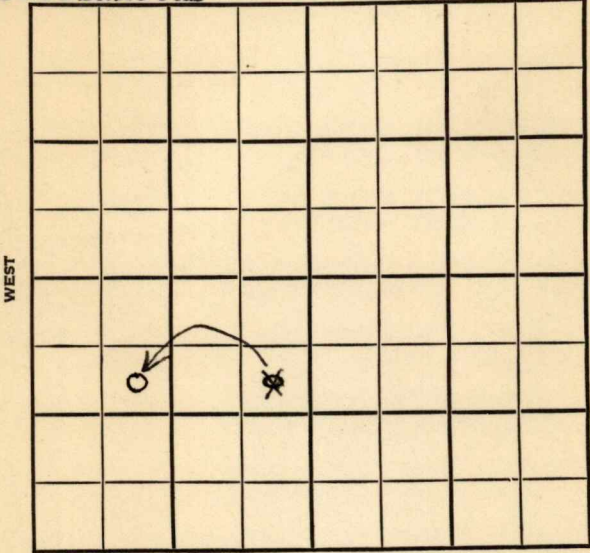

SOUTH

Sec. 21 Twp. 28 R. 4E


Well No. #1 Blood Farm
Aikman & Braden
Company

990 Ft. from N. Line

_____ Ft. from S. Line

_____ Ft. from E. Line

990 Ft. from W. Line
SE NW SW

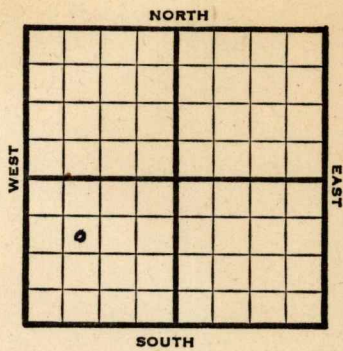

1947 REPORT

- 10/29 15" @ 42
Drlg. 110'
- 11/5 SD 240'
- 11/12 "
- 11/19 13" @ 746'
- 11/25 Drlg. 1280'
- 12/3 10" @ 1447'
Lansing 1680'
Drlg. 1780'
- 12/10 Drlg. 2200'
- 12/17 TD 2480' SO
- 12/30 **Simp. 2460'**
7" @ 2470'
Pump 20 Pot
38.0 Gr.
TD 2480'

COMPLETED

Map No. _____ Sec. 21 Twp. 28 R. 4E

Well No. 1 Blood

Aikman & Braden Company

FIRST REPORT Contractor

SE NW SW

SECTION PLAT

990 Ft. from N. Line

_____ Ft. from S. Line

_____ Ft. from E. Line

990 Ft. from W. Line

Butler County

Location _____

Rig up _____

Drilling and Remarks:

15" @ 42

drlg. 110

RECORD

Cased _____ in., _____ ft.

Sand _____

Gas _____

Oil _____

Total Depth _____

PRODUCTION

1st 24 hrs. Nat. _____

1st 24 hrs. after shot _____

Gas _____ Cu. Ft.

Dry Hole _____

Abandoned _____

Date

OCT 29 1947 19

S. J. LEWIS Scout

Map No. 11 Sec. 21 Twp. 28 R. 4E

Well No. 1 Blood

Aikman & Braden Company

COMPLETE

Contractor

SE NW SW

SECTION PLAT

990 Ft. from N. Line

_____ Ft. from S. Line

_____ Ft. from E. Line

990 Ft. from W. Line

Butler County

Location _____

Rig up _____

Drilling and Remarks:

Swamp 2460
7" @ 2470
Run 20 ft
CSG

RECORD

Cased _____ in., _____ ft.

Sand _____

Gas _____

Oil _____

Total Depth 2470

PRODUCTION

1st 24 hrs. Nat. _____

1st 24 hrs. after shot _____

Gas _____ Cu. Ft.

Dry Hole _____

Abandoned _____

Date

DEC 30 1947 19

S. J. LEWIS Scout