


DX 78-1 Cowley

KANSAS

Section 1 Township 30 Range 5E

Well No. #8 Brown

Company Franco-Central

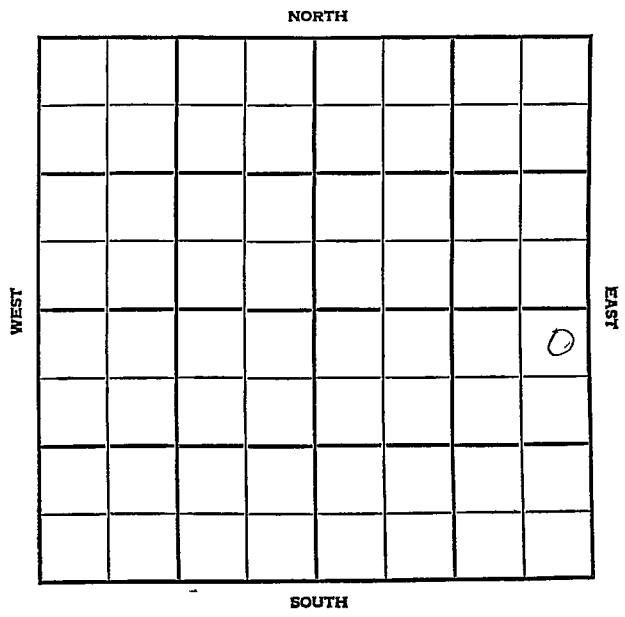

○

Cowley

KANSAS

SEC. 1	TWP. 30	R. 5E
-----------	------------	----------

WELL NO. #8 Brown FARM

COMPANY Franco-Central

CONTRACTOR


Gouch

_____ Ft. from N. Line

_____ Ft. from S. Line

_____ Ft. from E. Line

_____ Ft. from W. Line

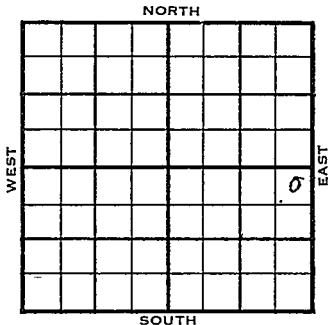

NE NE SE

1956	ELEVATION 1333	REPORT
------	-------------------	--------

3-21 Comm. 3-20-56
8" @ 125/70

4-11 5 1/2" @ 2772
CO to 2793 , frac
Comp. 25 bopd, 10% wtr.
KC 2147
Bart 2770
TD 2793

COMPLETED

County **Gowley** Elev. **1333**
 Sec. **1** Twp. **30 N** Rge. **5E**
 Company **Franco-Central**
 Farm Name **Brown** No. **8**

TOPS	DEPTH	LOG	DATUM	Loc. in Sec.
Anh.				NE NE SE
Tp.				
H.				
Tr.				
Dg.				
Bl.				
L.				
K.C.				Geol.
B.K.C.				Contr.
Ce.				
C.				
M.				Pool
M.				Couch
K.				
Mz.				
Mq.				
V.				
S.				
S.				
A				FIRST REPORT
R.				
PE.				
G.				
T.D.				

Date Comm. **3-20-56**
8" @ 125/70

FIRST REPORT		
MAR 21	1956	0

Co.
Lse.
No.
Sec.
T.
R.

County Cowley Elev. 1333
 Sec. 1 Twp. 30 Rge. 5E
 Company Franco-Central
 Farm Name Brown No. 8

TOPS	DEPTH	LOG	DATUM
Anh.			
Tp.			
H.			
Tr.			
Dg.			
Bl.			
L.			
K.C.	<u>2147</u>		<u>814</u>
B.K.C.			
Ce. <u>Bant</u>	<u>2770</u>		<u>1437</u>
C.			
M.			
M.			
K.			
Mz.			
Mq.			
V.			
S.			
S.			
A.			
R.			
PE.			
G.			
T.D.	<u>2793</u>		

Loc. in Sec. _____

NE NE SE

Geol. _____

Contr. _____

Pool _____

Couch

COMPLETE

Date Comm. 3-20-56 APR 1 1 19568" @ 125/70 5¹/₂" @ 2772 CU to 2793frac Comp. 25 bopd 10% wtr.