


Cowley

KANSAS

SECTION 1 TOWNSHIP 30 RANGE 5 E

WELL NO. #6 Brown Unit

COMPANY Stelhar Oil

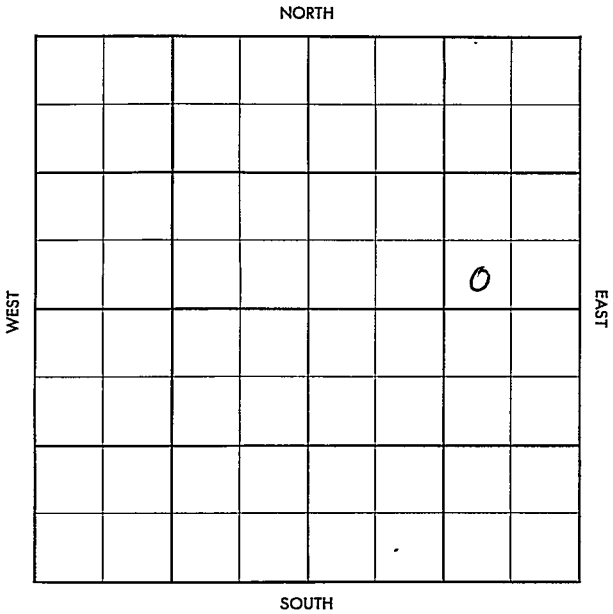

Cowley

KANSAS

SEC.

1

TWP

30

R.

5E

WELL NO.

#6 Brown Unit

FARM

COMPANY

Stelbar Oil

CONTRACTOR

Co Tools

Couch


_____ Ft. from N. Line

_____ Ft. from S. Line

_____ Ft. from E. Line

_____ Ft. from W. Line

SW SE NE

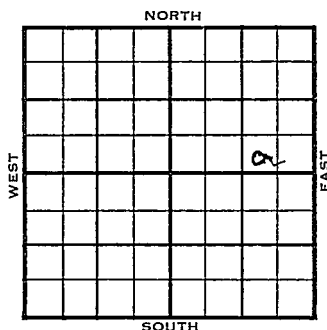

1955

ELEVATION

1322'

REPORT

11/9

Comm 11-2-55

8" @ 100

~~Bart~~ Bart 2776'

TD 2820

5" @ 2777

11-30

CO to 2820 frac,

F/ 50 bo,

Comp. 25 BOPD

Bart 2776'

TD 2820'

COMPLETED

County ~~Cowley~~ Elev. _____
 Sec. 1 Twp. (30) Rge. 5E
 Company Stellar Oil
 Farm Name Brown Unit No. 6

TOPS	DEPTH	LOG	DATUM	Loc. in Sec.
Anh.				SW SE NE
Tr.				
H.				
Tr.				
Dg.				
BL.				
L.				
K.C.				Geol. _____
B.K.C.				Contr. _____
Ce.				Co. tools
C.				
M.				Pool
M. <u>Bart.</u>	<u>2776</u>			<u>Couch</u>
K.				
Mz.				
Mq.				
V.				
S.				
S.				
A.				
R.				
PE.				
G.				
T.D.				

FIRST REPORT
 NOV 9 '55

Date Comm. 11-2-55
8" @ 100 TD 2820 5" @ 2777

Co.

Lse.

No.

Sec.

T.

R.

County Cowley Elev. 1322
 Sec. 1 Twp. 30 Rge. 5E
 Company Starbar Oil
 Farm Name Brown Unit No. 6

Co.

Lse.

No.

Sec.

T.

R.

TOPS

DEPTH

LOG

DATUM

Loc. in Sec.

SW SE NE

Anb.

Tp.

H.

Tr.

Dg.

Bl.

L.

K.C.

B.K.C.

Ce.

C.

M.

M.

K.

Mz.

Mq.

V.

S.

S.

A.

R.

Pe.

G.

TD.

Geol.

Contr.

Co. tools

Pool

Couch

COMPLETE

2820

1454

Date Comm. 11-2-55 NOV 30 1955

8" @ 100 TD 2820 5" @ 2777

CO to 2820 frac F/ 50 bo

Comp. 25 bond