

DX 78-1

Cowley


KANSAS

Section 1 Township 30S Range 5E

Well No. 5 W. E. Brown

Company France Central

NORTH

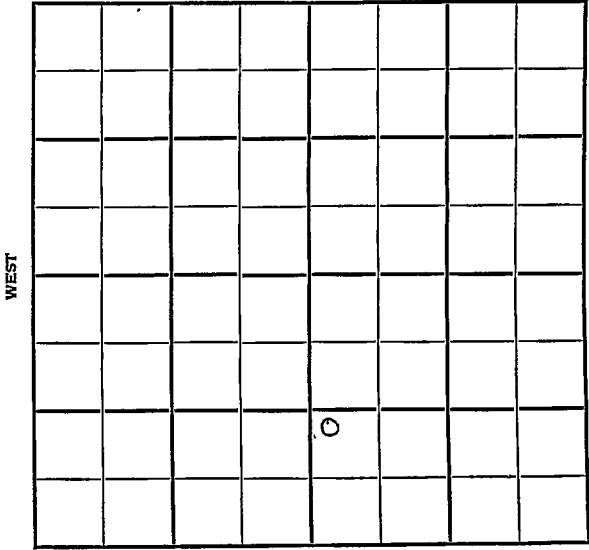

SOUTH

Cowley

KANSAS


SEC. 1	TWP. 30S	R. 5E
-----------	-------------	----------

WELL NO. #5 W. E.-Brown FARM COMPANY

CONTRACTOR Franco-Central

White & Ellis Couch

_____ Ft. from N. Line
 _____ Ft. from S. Line
 _____ Ft. from E. Line
 _____ Ft. from W. Line

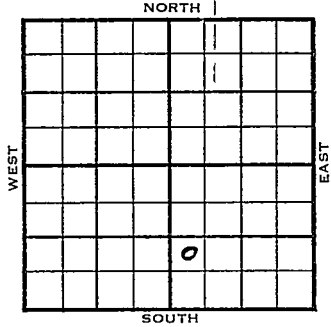

NW SW SE

FIRST REPORT

1955	ELEVATION 1344	REPORT
------	-------------------	--------

7/13 Spud 7/8/55
 8" 102 w/75 F 1846
 8/3 5 1/2" @2835/75
 CO to 2830 45/2816-24 frac
 Comp. 25 bopd
 Dg Bart 2812 1468
 TD 2835

COMPLETED

County Cowley Elev. _____
 Sec. 1 Twp. (20S) Rge. #5 SE
 Company Franco-Central
 Farm Name W. E. Brown No. 5

TOPS	DEPTH	LOG	DATUM
Anh.			
Tp.			
H.			
Tr.			
Dg.			
Bl.			
L.			
K.C.			
B.K.C.			
Ce.			
C.			
M.			
M.			
K.			
Mz.			
Ma.			
V.			
S.			
S.			
A.			
R.			
PE.			
G.			
T.D.			

Loc. in Sec. NW SW SE

Geol. _____
 Contr. White & Ellis

Pool Couch

JUL 13 1955
 FIRST REPORT

Date Comm. spd 7/8/55 8ⁿ 102 w/75 D1846

Co.
Lse.
No.
Sec.
T.
R.

