


DX 78-1

Section 1 Township 30 Range 5E

Well No. 7 Holt

Company Franco-Central

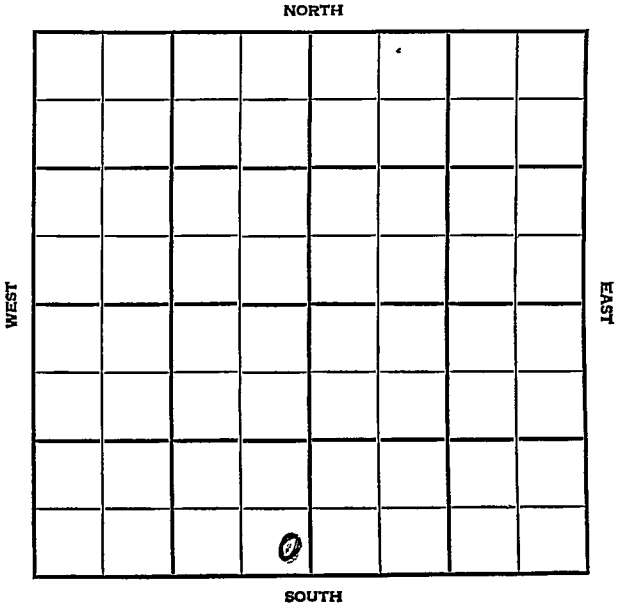

Cowley

KANSAS


SEC.	TWP.	R.
I	30	5E

WELL NO. **7 Holt** FARM

COMPANY **Franco Central**

CONTRACTOR **White & Ellis  
Couch**

\_\_\_\_\_ Ft. from N. Line  
 \_\_\_\_\_ Ft. from S. Line  
 \_\_\_\_\_ Ft. from E. Line  
 \_\_\_\_\_ Ft. from W. Line

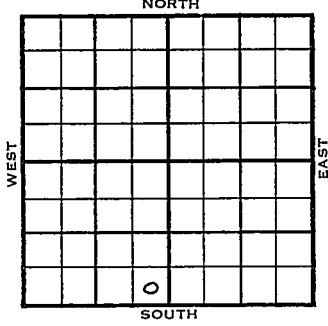

**SE SE SW**

	ELEVATION	REPORT
1955	1364'	

6/29 M I R  
 7/20 Comm 6-30-55  
 8 5/8" @120/75 5 1/2" @2865  
 45/2856-61 frac S/20 boph Comp. 95 bopd  
 Tops:      Depth      Datum  
 KC            2202            838  
 BKC          2800            1436  
 TD            2866

**COMPLETED**

County Cowley Elev. \_\_\_\_\_  
 Sec. 1 Twp. 30 Rge. 5E  
 Company Franco-Central  
 Farm Name Holt No. 7

TOPS	DEPTH	LOG	DATUM
Anh.			
Tr.			
H.			
Tr.			
Dg.			
Bl.			
L.			
K.C.			
B.K.C.			
Ce.			
C.			
M.			
M.			
K.			
Mz.			
Me.			
V.			
S.			
S.			
A			
R.			
Pe.			
G.			
T.D.			

Loc. in Sec. \_\_\_\_\_  
SE SE SW  
 Geol. \_\_\_\_\_  
 Contr. \_\_\_\_\_  
White & Elli  
 Pool \_\_\_\_\_  
Couch  
 JUN 29 1955  
**FIRST REPORT**  
 0

Date Comm. \_\_\_\_\_  
M I R

Co.  
 Lsg.  
 No.  
 Sec.  
 T.  
 R.

