

Russell


FORM 51 5M BRIX

KANSAS

Section 28 Township 13 Range 14W

Well No. #1 Mai

Company Raymond Gear etal

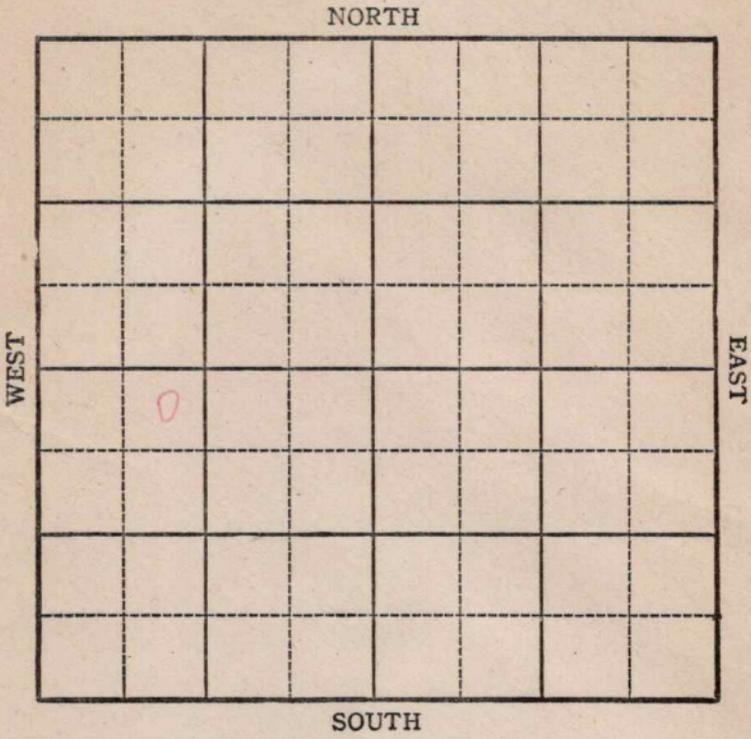

KANSAS

Sec. 28 Twp. 13 R. 14W

#1 Mai

Well No. _____ Farm _____

Raymond Gear Etal

Company _____


Russell

330 Ft. from N. Line

_____ Ft. from S. Line

_____ Ft. from E. Line

990 Ft. from W. Line

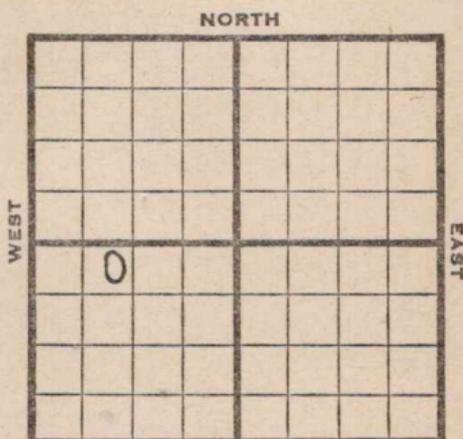

NE NW SW

Elev. 1856

SOUTH

1944

R E P O R T

12/20	Location
12/29	"
1945	
1/3	"
1/10	Mach
1/17	15" @345 Drlg 470
1/26	Anhy 905 10" @ 905' Drlg. 1500'
1/31	Drlg. 2355'
2/7	Drlg 2800 Run 7"
2/14	Drlg 3050 UR 7"
2/21	Lans 3020 7" @ 3136 Drlg 3200
2/28	Arb 3289 TD 3314 1400' oil 12 hrs 5" @ 3308 WOC
3/7	SLM 3314 equal 3311 TD Arb 3286 5" @ 3306 2700 oil 500 acid
3/14	" " " "
3/23	" " " "
3/29	" " " "
4/5	Building tanks

OVER

732253

1945

4/12 Building tanks

4/20 " "

4/27 " "

5/3 " "

5/16 Arb 3286

5" @ 3306'

TD 3311

5000acid

Pump 150 Pot.

Grav. 33.0

COMPLETED

Pool Name Russell

Map No. 72 Sec. 28 Twp. 13 R. 14W

Well No. 1 Mai

Raymond Gear Etal Company

FIRST REPORT

Contractor

NE NW SW


330 Ft. from N. Line

_____ Ft. from S. Line

_____ Ft. from E. Line

990 Ft. from W. Line

SECTION PLAT

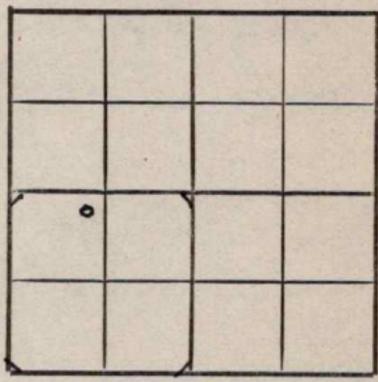

Russell

Location X

Rig up _____

Drilling and Remarks:

RECORD

Cased _____ in., _____ ft.

Sand _____

Gas _____

Oil _____

Total Depth _____

PRODUCTION

1st 24 hrs. Nat. _____

1st 24 hrs. after shot. _____

Gas _____ Cu. Ft.

Dry Hole _____

Abandoned _____

Date

DEC 20 1944 19

S. J. LEWIS

Scout

Kansas Pool Name Russell

Map No. 72 Sec. 28 Twp. 13 R. 14W

Well No. 1 Mai

Raymond Gear et al Company

COMPLETED

Contractor

NE NW SW

E. 1856

SECTION PLAT

330 Ft. from N. Line

_____ Ft. from S. Line

_____ Ft. from E. Line

990 Ft. from W. Line

o			

Russell County

Location _____

Rig up _____

Drilling and Remarks:

Car x 3286
5" @ 3306
500 acid
Pump 150 P.D.

33° SW

RECORD

Cased _____ in., _____ ft.

Sand _____

Gas _____

Oil _____

Total Depth 3311

PRODUCTION

1st 24 hrs. Nat. _____

1st 24 hrs. after shot _____

Gas _____ Cu. Ft.

Dry Hole _____

Abandoned _____

Date

MAY 16 1945 19

S. J. LEWIS Scout