




Russell  
13 14<sup>W</sup>

Map No. **KANSAS** Sec. 28 Twp. 13 R. 14<sup>W</sup>

Well No. #7 # Killeyan Farm  
Palmer Company

Ft. from N. Line  
330 Ft. from S. Line  
Ft. from E. Line  
990 Ft. from W. Line  
Elev. 1853

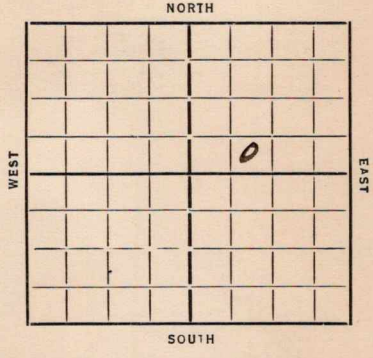

Date	REPORT
10/30	Ring
11/7	R. G.
11/14	Log 405
11/24	
11/29	Log 515 15" 272
12/6	Log Aubrey 876 10" 890
	Log 1820
12/13	Log 2395-2400
	Log 2425-30 8" 2453
	Log 2530
12/19	Log Joseph 2710
	Log Oswald 3007
	6" 3011 405 HFW 3030
	Log 3110
12/26	TD 3250 Ring 5"
1/2/36	
1/8	Log 3272
	TD 3291 HFW
	D & A.

**ABANDONED**

Map No. 72 Sec. 28 Twp. 13 R. 14W

Well No. 1 - Killyon

Palmer Company

Contractor

FIRST REPORTS

SECTION PLAT

		o	

Ft. from N. Line

330 Ft. from S. Line

Ft. from E. Line

990 Ft. from W. Line

Location

Rig up

Drilling and Remarks:

Rig

RECORD

Cased \_\_\_\_\_ in., \_\_\_\_\_ ft.

Sand \_\_\_\_\_

Gas \_\_\_\_\_

Oil \_\_\_\_\_

Total Depth \_\_\_\_\_

PRODUCTION

1st 24 hrs. Nat. \_\_\_\_\_

1st 24 hrs. after shot \_\_\_\_\_

Gas \_\_\_\_\_ Cu. Ft.

Dry Hole \_\_\_\_\_

Abandoned \_\_\_\_\_

Date

10-30-35 192

ORVAL MANNSCHRECK

Scout

KANSAS

Map No. 72 Sec. 28 Twp. 13 R. 14W

Well No. 7 - Killyon  
Palmer Company

Contractor

SECTION PLAT


..... Ft. from N. Line

330 Ft. from S. Line

..... Ft. from E. Line

990 Ft. from W. Line

CORRECTION

Location.....

Rig up.....

Drilling and Remarks:

*has been carried as  
#1 - changed  
to #7*

RECORD

Cased..... in., ..... ft.

Sand.....

Gas.....

Oil.....

Total Depth.....

PRODUCTION

1st 24 hrs. Nat.....

1st 24 hrs. after shot.....

Gas..... Cu. Ft.

Dry Hole.....

Abandoned.....

Date

12-18-35 192.....

ORVAL MANNSCHRECK  
Scout

KANSAS

Map No. 72 Sec. 28 Twp. 13 R. 14W

Well No. 7-Killyon

Palmer Company

Contractor

SECTION PLAT

		0	

Ft. from N. Line

330 Ft. from S. Line

Ft. from E. Line

990 Ft. from W. Line

COMPLETED

Location.....

Rig up.....

Drilling and Remarks:  
hfw  
D. & A.

RECORD

Cased..... in., ..... ft.

Sand Sil 3272

Gas.....

Oil.....

Total Depth 3291

PRODUCTION

1st 24 hrs. Nat.....

1st 24 hrs. after shot.....

Gas..... Cu. Ft.

Dry Hole.....

Abandoned.....

Date

JAN 8 1936