

Cowley

KANSAS

SECTION 1 TOWNSHIP 30 RANGE 5 E

WELL NO. #1 Holt "B"

COMPANY Franco-Central

NORTH

WEST

EAST

	0						

SOUTH

Cowley

KANSAS

SEC. 1	TWP. 30	R. 5E
-----------	------------	----------

WELL NO.

#1 Holt "B"

FARM

COMPANY

Franco-Central

CONTRACTOR

White & Ellis


Couch

_____ Ft. from N. Line

_____ Ft. from S. Line

_____ Ft. from E. Line

_____ Ft. from W. Line

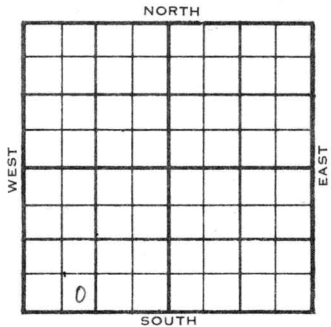

SE SW SW

1956	ELEVATION 1356'	REPORT
------	--------------------	--------

~~###~~

1-11

Comm. 1-7-56
8" @ 141/105
Drlg. 1500'

2-1

5 1/2" @ 2845
CO to 2855, frac
Comp. 25 ~~bp~~ bopd, 100 bw
Bart 2844
TD 2855

COMPLETED

County Cowley Elev. _____
 Sec. 1 Twp. 30 Rge. 5E
 Company Franco-Central
 FarmName Holt "B" No. 1

TOPS	DEPTH	LOG	DATUM	Loc. in Sec.
Anh.				SE SW SW
Tp.				
H.				
Tr.				
Dg.				
Bl.				
L.				Geol. _____
K.C.				Contr. _____
B.K.C.				White & Elli
Ce.				
C.				Pool _____
M.				Couch
K.				
Mz.				
Mq.				
V.				
S.				
S.				
A.				
R.				
Pe.				FIRST REPORT
G.				
T.D.				

Date Comm. 1-7-56
8" @ 141/105 drlg. 1500

Co.
 No.
 Sec.
 T.
 R.

County Cowley Elev. 1356
 Sec. 1 Twp. 30 Rge. 5E
 Company Franco-Central
 FarmName Holt "B" No. 1

Co.

TOPS	DEPTH	LOG	DATUM	Loc. in Sec.
Anh.				SE SW SW
Tr.	<u>Bart</u>	<u>2844</u>	<u>1488</u>	
Dg.				
Bl.				
L.				Geol.
K.C.				Contr.
B.K.C.				White & Ell
Ce.				
C.				Pool
M.				Couch
Mz.				
Me.				
V.				
S.				
S.				
A.				
R.				
Pe.				
G.				
T.D.	<u>2855</u>			

Lsec

No.

Sec.

T.

R.

Date Comm. 1-7-56 FEB 1 1956

8" @ 141/105 5 $\frac{1}{2}$ " @ 2845 CO to 2855

frac Comp. 25 bopd 100 bw

