


KANSAS Russell County

FORM 51 5M PETROL

Section 28 Township 13 Range 14W

Well No. 2 Mai

Company Raymond Gear etal

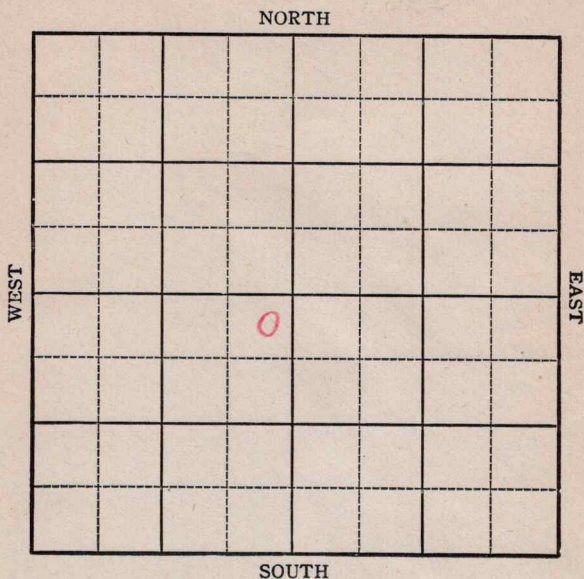

KANSAS

Russell

Sec. 28 Twp. 13 R. 14W

Well No. 2 Mai Farm

Raymond Gear etal Company


Russell

330 Ft. from N. Line

_____ Ft. from S. Line

330 Ft. from E. Line

_____ Ft. from W. Line

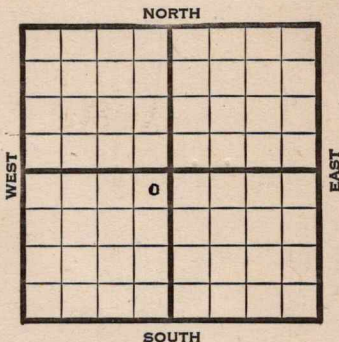

NE SW Elev. 1860

1945

REPORT

Date	Location
5/16	Location
5/24	"
5/31	"
6/8	"
6/14	"
6/21	"
6/28	"
7/3	"
7/11	"
7/19	"
7/26	15" @ 375 Drlg. 390
8/1	Anhy 881 10" @ 884 Drlg. 1095
8/8	Drlg. 2105
8/15	8" @ 2465 Drlg. 2472
8/22	Topeka 2730 SO 2966-2967 Drlg. 2970'
8/29	Lans 2996 SO 3020-3025 TD 7" @ 3017
9/5	2000 acid. Pump 5 oil plus 5 WPH
9/12	" " " "
9/19	" " " "
9/26	" " " "
10/3	Drlg. 3240'

OVER

732270

1945

10/10 TD 3269
5" @ 3250 RUST
10/17 5" @ 3270
TD 3288
2600' oil 15 hrs.
10/24 S.D. for Pumping unit
10/31 S.D. 3288
11/7 " "
11/14 " "
11/21 " "
11/28 " "
12/5 **Lans 2996**
7" @ 3017
5" @ 3270
2000 acid.
TD 3288'
Pump 100 Pot.
Grav. 34.0

COMPLETED

Kansas Pool Name Russell

Map No. 72 Sec. 28 Twp. 13 R. 14W

Well No. 2 Mai

Raymond Gear etal Company

FIRST REPORT

Contractor

NE SW

SECTION PLAT

330 Ft. from N. Line

_____ Ft. from S. Line

330 Ft. from E. Line

_____ Ft. from W. Line

Russell

Location E

Rig up _____

Drilling and Remarks:

RECORD

Cased _____ in., _____ ft.

Sand _____

Gas _____

Oil _____

Total Depth _____

PRODUCTION

1st 24 hrs. Nat. _____

1st 24 hrs. after shot _____

Gas _____ Cu. Ft.

Dry Hole _____

Abandoned _____

Date

MAY 16 1945 19

S. J. LEWIS Scout

