

Russell

KANSAS

Section 29 Township 13 Range 14-W


Well No. 1 M. G. Miller

Company Lauck & Moncrief


Sec. 29 Twp. 13 R. 14-WWell No. #1 M. G. Miller FarmLauch & Moncrief Company330 Ft. from N. Line Ft. from S. Line Ft. from E. Line990 Ft. from W. Line

Elev. 1862

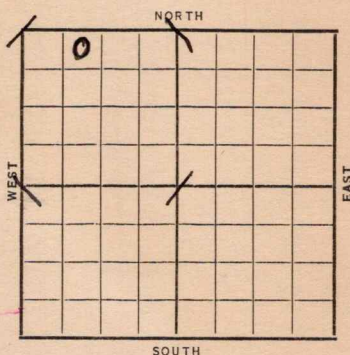

Date

REPORT

1938

3/23 10" @ 535'. Drl g. 745'.

4/1 Anhy 885'. Drl g. 2630'.

4/8 Sand 3022'. S.O. 3024-35'.

Lans. 3033'. S.O. 3041-47'.

Sat. 3075-80'. Cong. 3304'.

Coring 3306'.

4/15 Arb. 3353'. T.D. 3378' S.W.

P.B. 3090'. 7" @ 3022'.

RUST.

4/22 " " " " "

4/27 Arb. 3353'.

T.D. 3378' S.W.

P.B. 3090'.

7" @ 3022'.

6000 acid.

Swab 20% oil & 80% water.

ABANDONED

ABANDONED

Map No. 72 Sec. 29 Twp. 13 R. 14WWell No. 1 M. G. MillerLauck & Moncrief Company


Contractor

I. T. I. O. Farmout

FIRST REPORT

SECTION PLAT

NE NW NW

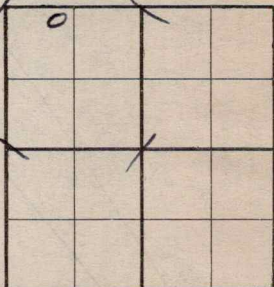330 Ft. from N. Line Ft. from S. Line Ft. from E. Line990 Ft. from W. LineLocation Rig up

Drilling and Remarks:

10" - 535Drlg. 745

RECORD

Cased in., ft.Sand Gas Oil Total Depth

PRODUCTION

1st 24 hrs. Nat. 1st 24 hrs. after shot Gas Cu. Ft.Dry Hole Abandoned

Date

MAR 23 1938

19

H. D. Hatfield Scout

Map No. 72 Sec. 29 Twp. 13 R. 14WWell No. 1 M. G. MillerLauck & Moncrief

Company

Contractor

ABANDONED

NE NW NW

SECTION PLAT

0			

330 Ft. from N. Line

_____ Ft. from S. Line

_____ Ft. from E. Line

990 Ft. from W. Line

Location _____

RECORD

Cased _____ in., _____ ft.

Sand Arb 3353

Gas _____

Oil _____

Total Depth 3378 SW

PRODUCTION

1st 24 hrs. Nat. _____

1st 24 hrs. after shot _____

Gas _____ Cu. Ft.

Dry Hole _____

Abandoned _____

Drilling and Remarks:

P.B. 30907" 30226000 acidSWB. 20 90 oil480 90 wtrD & A

Date

APR 27 1938

19

H. D. Hatfield

Scout