

KANSAS


Russell

Section 29 Township 13 Range 14W

Well No. 1 Miller

Company Summit Oil

Hall-Gurney
NORTH

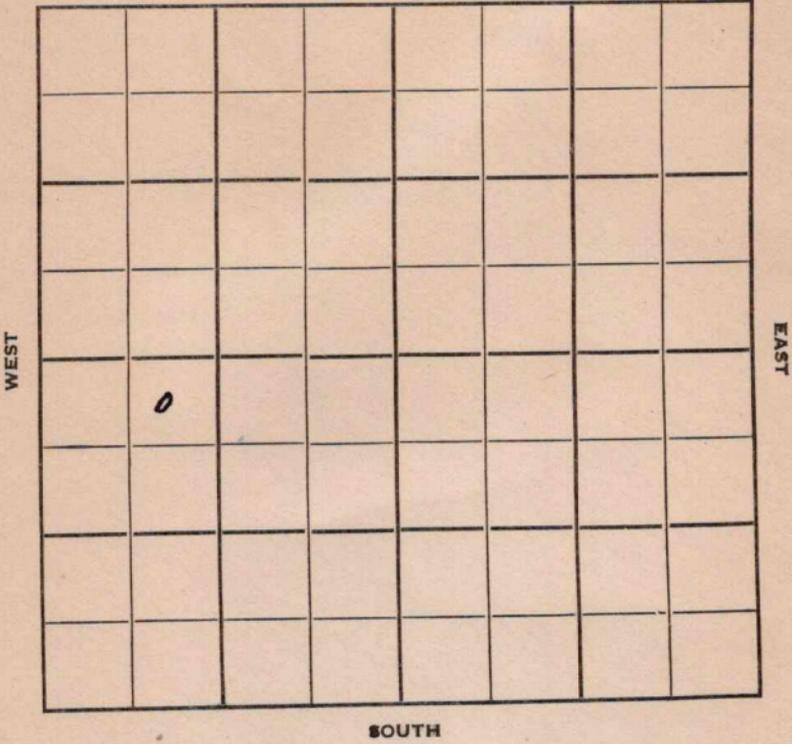

KANSAS

Russell

Sec. 29 Twp. 13 R. 14W

Well No. #1 Miller Farm _____

Summit Oil Company _____


(Stearns Drlg., Cont.) NORTH

330' Ft. from N. Line
Hall-Gurney

_____ Ft. from S. Line

_____ Ft. from E. Line

990' Ft. from W. Line

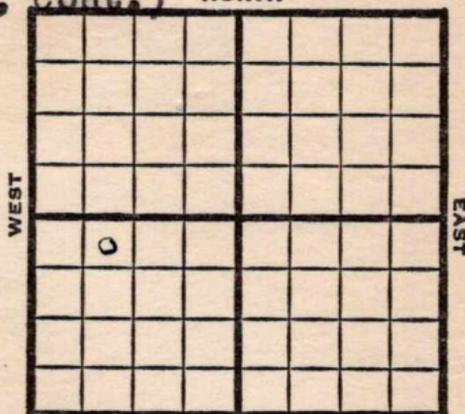

NE NW SW Twin Well SOUTH

1949 **Elev 1865'** REPORT

- 5/11 Rig
- 5/18 Drlg 358'
- 5/25 13"@ 455'
Drlg 945'
- 6/1 Drlg 1640'
- 6/7 Drlg. 2110'
- 6/15 Drlg 2850'
- 6/21 8"@ 2548'
Lansing 3028
7"@ 3078'
Drlg 3100'
- 6/28 **Arb. 3297'**
TD 3325'
5"@ 3320'
- 7/6 TD 3333'
5"@ 3331'
- 7/12 TD 3346'
HFW
PB 3322'
22 shots 3300-07'
500 acid
- 7/20 8 shots 3305-08'
500 acid wtr.
- 7/27 "

OVER

1949

732285

8/3

TD 3346'

Arb. 3297'

5" @ 3320'

1500 Acid

Pump 80 Oil Pot

40⁹ Gr.

Comp

COMPLETED

Map No. _____ Sec. 29 Twp. 13 R. 14W

Well No. 1 Miller

Summit Oil Company

Stearns Drlg. Contractor

NE NW SW

FIRST REPORT
SECTION PLAT

330 Ft. from N. Line

_____ Ft. from S. Line

_____ Ft. from E. Line

990 Ft. from W. Line

Russell County

Location _____

Rig up _____

Drilling and Remarks:

twin well
rig

RECORD

Cased _____ in., _____ ft.

Sand _____

Gas _____

Oil _____

Total Depth _____

PRODUCTION

1st 24 hrs. Nat. _____

1st 24 hrs. after shot _____

Gas _____ Cu. Ft.

Dry Hole _____

Abandoned _____

Date

MAY 11 1949 19

S. J. LEWIS Scout

Kansas

Hall-Gurney Pool

Map No. K 72 Sec. 29 Twp. 13 R. 14W

Well No. 1 Miller

Summit Oil

Company /

COMPLETE

Contractor

NE NW SW

E. 1, 1865
SECTION PLAT

330 Ft. from N. Line

_____ Ft. from S. Line

_____ Ft. from E. Line

990 Ft. from W. Line

Russell County

Location _____

Rig up _____

Drilling and Remarks:

Case 3297
5" casing
1500 acid
Pump 50 oil Prod.
40 lbs.

RECORD

Cased _____ in., _____ ft.

Sand _____

Gas _____

Oil _____

Total Depth 3346

PRODUCTION

1st 24 hrs. Nat. _____

1st 24 hrs. after shot _____

Gas _____ Cu. Ft.

Dry Hole _____

Abandoned _____

Date

AUG 3 1949 19

S. J. LEWIS

Scout