


Section 29 Township 13 Range 14 W

Well No. # 1 Miller

Company Fink et al

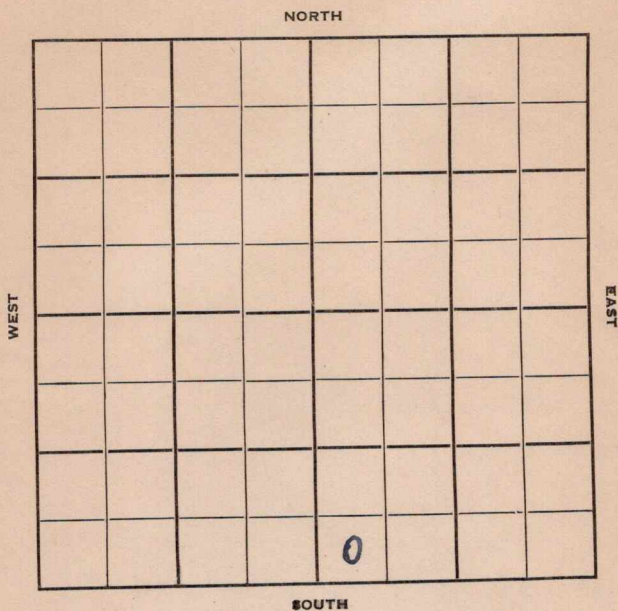

Russell

KANSAS



Sec. 29 Twp. 13 R. 14W

Well No. #1 Miller Farm

Fink et al Company


Fleming & Woodman Contractor

\_\_\_\_\_ Ft. from N. Line

330 Ft. from S. Line

\_\_\_\_\_ Ft. from E. Line

330 Ft. from W. Line  
SW SW SE

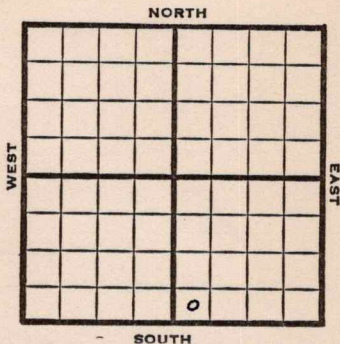

1952 **Elev. 1872** REPORT

10/1 Spud 9-23-52  
8" @ 155 **Anhy**  
Drlg. 2399

10/15 Spud 9-23-52  
Oil Well TD 3323  
8" @ 155' **Anhy 920 Top. 2702**  
**Heeb. 2992 Tor. 3014**  
**Lans. 3042 Arb. 3311**  
TD 3314 5" @ 3312 DD 3317  
500 A S/  $\frac{1}{2}$  boph DD 3323  
1000 A S/ 7 boph Comp. 100 bopd

**COMPLETED**



