

KANSAS


FORM 51 IOM 12-46 PETROL

Cowley county

Section 5 Township 30 Range 5-E

Well No. #2, Combs

Company Kewanee Oil

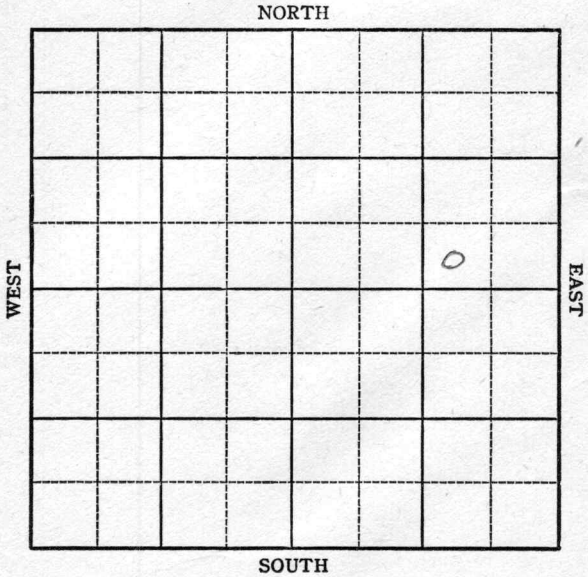

KANSAS

Cowley

Sec. 5 Twp. 30 R. 5-E

Well No. #2, Combs Farm

Kewanee Oil Company Company


Miscellaneous

 Ft. from N. Line

330' Ft. from S. Line

990' Ft. from E. Line

 Ft. from W. Line

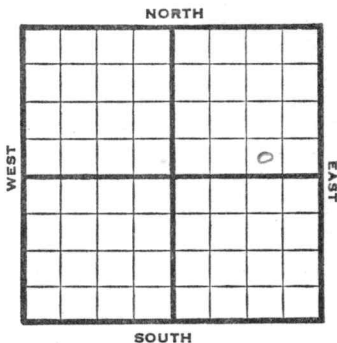

SW SE NE

REPORT

1947

1308

- 1/22 Machine
- 1/30 Drlg 270'
- 2/5 15" @ 345'
13" @ 943'
Drlg 1335'
- 2/12 10" @ 1435'
Drlg 1980'
- 2/19 2007 fsg
- 2/26 " "
- 3/4 2007 fsg
- 3/11 2007 fsg
- 3/18 Bart 2824'
TD 2827'
7" @ 2815'
P.B.P.
- 3/25 Miss 2868
TD 2870'
PB 2850'
70 qts 2825-49 CO
- 4/2 " " " "

OVER

4/9

Bart 2824

7" @ 2815

Miss 2868

PB 2850

Pump 250 Pot

Grav. 40

TD 2870'

COMPLETED

Map No. 11 Sec. 5 Twp. 30 R. 5E

Well No. 2 Combs

Kewanee Oil Company

FIRST REPORT

Contractor

SW SE NE

SECTION PLAT

			o

 Ft. from N. Line

330 Ft. from S. Line

990 Ft. from E. Line

 Ft. from W. Line

Cowley County

Location

Rig up

Drilling and Remarks:

Machine

RECORD

Cased in., ft.

Sand

Gas

Oil

Total Depth

PRODUCTION

1st 24 hrs. Nat.

1st 24 hrs. after shot

Gas Cu. Ft.

Dry Hole

Abandoned

Date

JAN 22 1947 19

S. J. LEWIS Scout

Map No. K11 Sec. 5 Twp. 30 R. 5E

Well No. 2 Combs

Kewanee Oil Company

COMPLETE Contractor
SW SE NE E 11308

SECTION PLAT

 Ft. from N. Line

330 Ft. from S. Line

990 Ft. from E. Line

 Ft. from W. Line

Cowley County

Location

Rig up

Drilling and Remarks:

Bar 2824
7" @ 2815
Misc 2868
982860

Pring 150 ft

40 2/3

RECORD

Cased in., ft.

Sand

Gas

Oil

Total Depth 2870

PRODUCTION

1st 24 hrs. Nat.

1st 24 hrs. after shot

Gas Cu. Ft.

Dry Hole

Abandoned

Date

APR 9 1947 19

S. J. LEWIS Scout