


Map No. _____ Sec. 21 Twp. 28 R. 4Well No. 1 Nm Frank Farm
Mud Kansas Company

NORTH

WEST

EAST

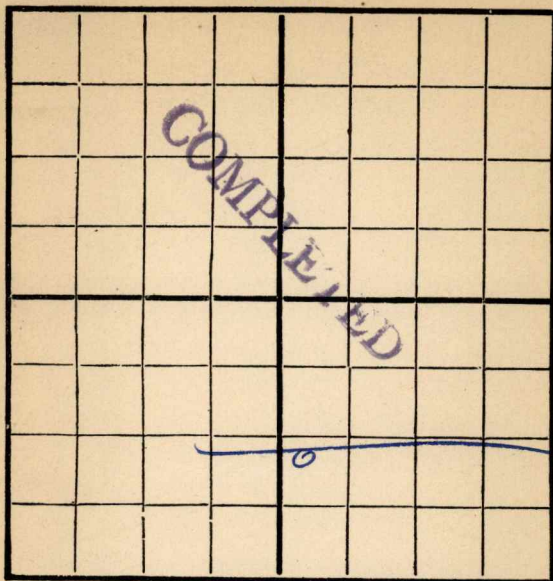

SOUTH

Location _____

Rig Up _____

Drilling Remarks:

Drilling Remarks:

5/2 2270 ft
5/17 2625

RECORD

Cased _____ in _____ Ft.

Sand _____

Gas _____

Oil _____

Total Depth _____

PRODUCTION

1st 24 hrs. Nat. _____

1st 24 hrs. after shot _____

Gas _____ Cu. Ft.

Dry Hole _____


Abandoned _____

Map No. _____ Sec. 21 Twp. 28 R. 4Well No. 1 Wm Frank Farm _____Mid-Kansas Oil Company _____

NORTH

WEST

EAST

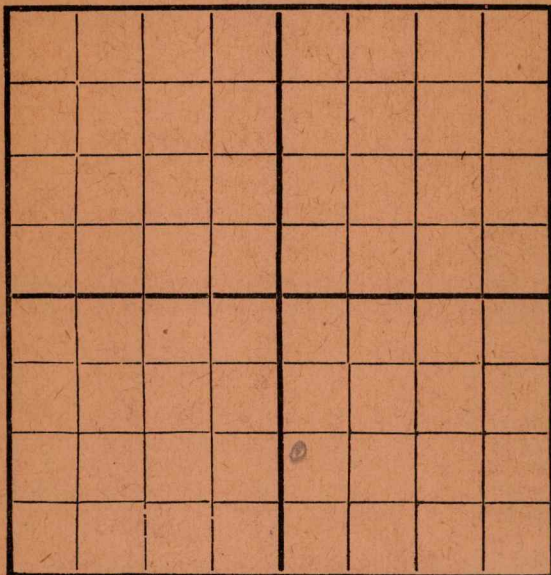

SOUTH

Location _____

Rig Up _____

Drilling and remarks

2270 ft

RECORD

Cased _____ in. _____ Ft.

Sand _____

Gas _____

Oil _____

Total Depth _____

PRODUCTION

1st 24 hrs. Nat. _____

1st 24 hrs. after shot _____

Gas _____ Cu. Ft.

Dry Hole _____

Abandoned _____

Date


May 2, 1916 L. L. L. L. L. Scout

Map No. _____ Sec. 21 Twp. 28 R. 4
 Well No. 1 Wm B Loe Farm _____
Mid. Kansas Company _____

NORTH

WEST

EAST

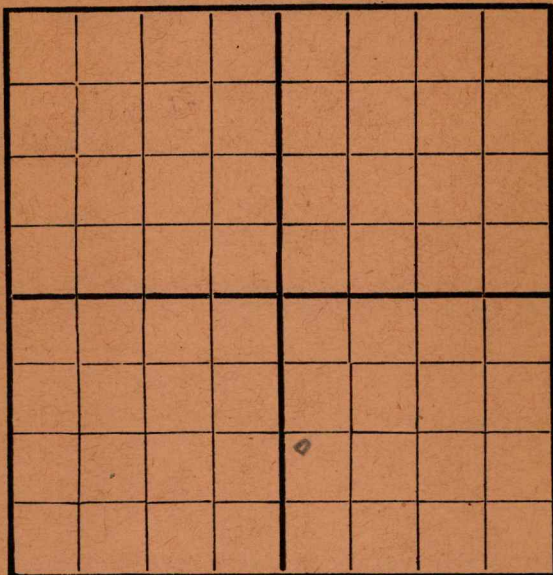

SOUTH

Location _____
 Rig Up _____
 Drilling and remarks _____

2620ft

RECORD

Cased _____ in. _____ Ft.
 Sand _____
 Gas _____
 Oil _____
 Total Depth _____

PRODUCTION

1st 24 hrs. Nat. _____
 1st 24 hrs. after shot _____
 Gas _____ Cu. Ft.
 Dry Hole _____
 Abandoned _____

Date

5/8

1916


L. C. C. Co.

Scout

Map No. _____ Sec. 21 Twp. 28 R. 4
 Well No. Bloss Farm _____
Mid Kansas Company _____

NORTH

WEST

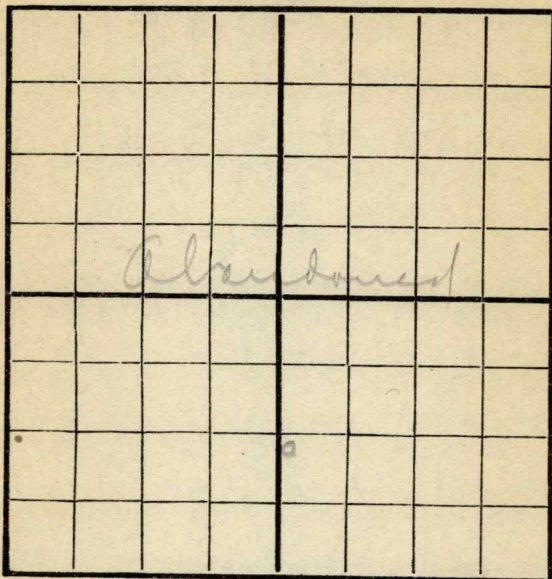

EAST

SOUTH

Location _____
 Rig Up _____
 Drilling and remarks _____

2625-Dry

RECORD

Cased _____ in. _____ Ft.
 Sand _____
 Gas _____
 Oil _____
 Total Depth _____

PRODUCTION

1st 24 hrs. Nat. _____
 1st 24 hrs. after shot _____
 Gas _____ Cu. Ft.
 Dry Hole _____
 Abandoned _____

Date

1916 _____ Scout

RECEIVED
 RECEIVED TO
 MAY 10 1916


RECEIVED

Map No. _____ Sec. 21 Twp. 28 R. 4
 Well No. Wm. Frank Bloss Farm
Mid Kansas Company

NORTH

WEST

EAST

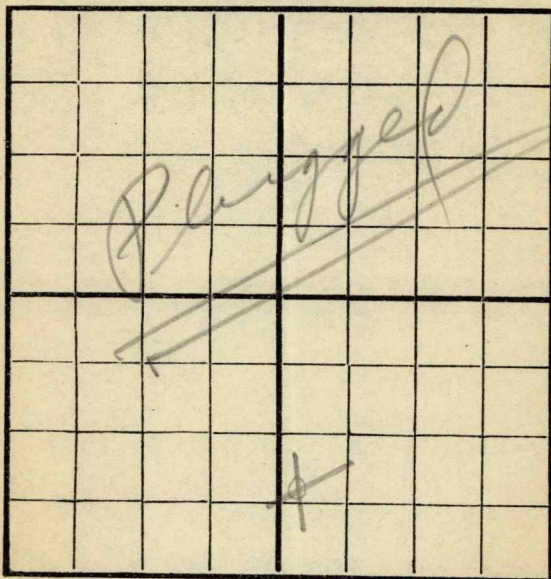

SOUTH

Location _____
 Rig Up _____
 Drilling and remarks _____

RECORD

Cased _____ in. _____ Ft.
 Sand _____
 Gas _____
 Oil _____
 Total Depth _____

PRODUCTION

1st 24 hrs. Nat. _____
 1st 24 hrs. after shot _____
 Gas _____ Cu. Ft.
 Dry Hole _____
 Abandoned _____

Date


6/28, 1916 Wm. Frank Bloss Scout

Map No. _____ Sec. 21 Twp. 28 R. 4
 Well No. 1 Bloss Farm _____
Mid Kansas Company _____

NORTH

WEST

EAST

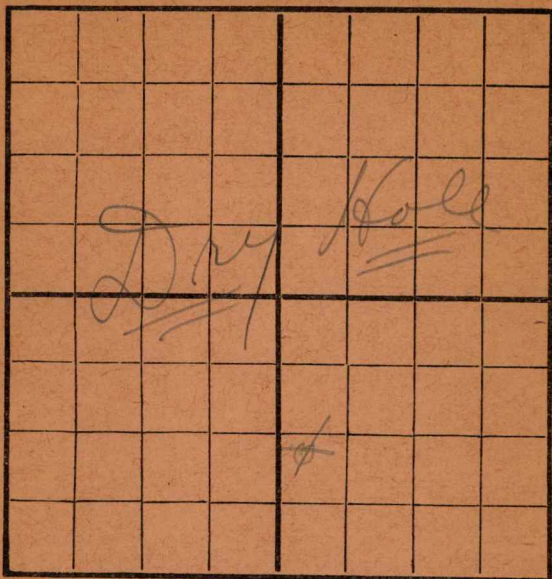

SOUTH

Location _____

Rig Up _____

Drilling and remarks

RECORD

Cased _____ in. _____ Ft.

Sand _____

Gas _____

Oil _____

Total Depth _____

PRODUCTION

1st 24 hrs. Nat. _____

1st 24 hrs. after shot _____

Gas _____ Cu. Ft.

Dry Hole _____

Abandoned _____

Date

6/30, 1916 L. C. Campbell Scout

Dry
 On 28th section
 report it was finished
 was later to day it was
dry