

Map No. _____ Sec. 21 Twp. 28 R. 4Well No. 8 Smith Farm __________Empire_____
Company

NORTH

WEST

EAST

SOUTH

Location _____

Rig Up _____

Drilling Remarks:

Drilling Remarks:

10/30 = 15501820 = 11/92035 = 11/142390 = 11/272460 = Top sand = 12/4

RECORD

PRODUCTION

Cased _____ in _____ Ft.

1st 24 hrs. Nat. 200 bblsSand 2460 - 2484

1st 24 hrs. after shot _____

Gas _____

Gas _____ Cu. Ft.

Oil _____

Dry Hole _____

Total Depth _____

Abandoned _____

Map No. _____ Sec. 21 Twp. 28 R. 4
 Well No. 8 Swindle Farm _____
Engine Company _____

NORTH

WEST

EAST

SOUTH

Location _____

Rig Up _____

Drilling and remarks

1820

RECORD

Cased _____ in. _____ Ft.

Sand _____

Gas _____

Oil _____

Total Depth _____

PRODUCTION

1st 24 hrs. Nat. _____

First 24 hrs. after shot _____

Gas _____ Cu. Ft.

Dry Hole _____

Abandoned _____

Date

7/9, 1916 Reed Scout _____

Map No. _____ Sec. 21 Twp. 28 R. 4
 Well No. 8 _____ Farm _____
 _____ Company _____

NORTH

WEST

EAST

SOUTH

Location _____

Rig Up _____

Drilling and remarks

2035

RECORD

Cased _____ in. _____ Ft.

Sand _____

Gas _____

Oil _____

Total Depth _____

PRODUCTION

1st 24 hrs. Nat. _____

First 24 hrs. after shot _____

Gas _____ Cu. Ft.

Dry Hole _____


Abandoned _____

Date

11/14, 1916 Cardiff Scout

Map No. _____ Sec. 31 Twp. 28 R 4
Well No. 8 _____ Farm _____
Empire _____ Company _____

NORTH

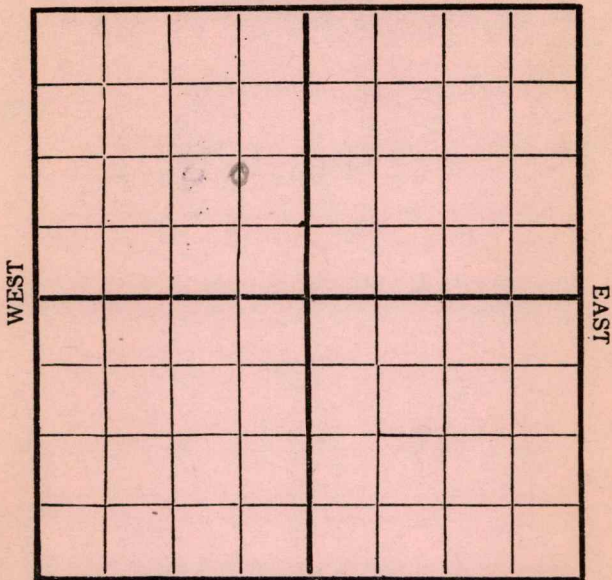

SOUTH

Location _____
Rig Up _____
Drilling and remarks _____

2200

RECORD

Cased _____ in. _____ Ft.
Sand _____
Gas _____
Oil _____
Total Depth _____


PRODUCTION

1st 24 hrs. Nat. _____
1st 24 hrs. after shot _____
Gas _____ Cu. Ft.
Dry Hole _____
Abandoned _____

Date

4/30 1916 Cordell Scout

Map No. _____ Sec. 21 Twp. 28 R. 4
Well No. 8 Smith Farm _____
Engine Company _____
NORTH

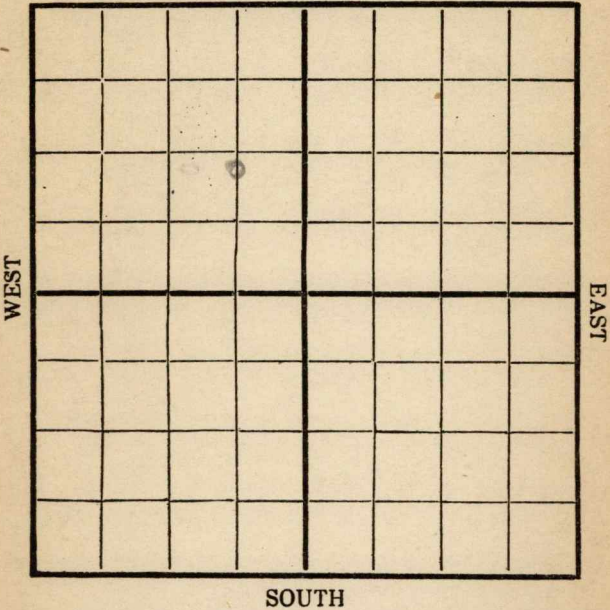


Location _____ Rig Up _____ Drilling and remarks <u>2390</u>	RECORD
	Cased _____ in. _____ Ft.
	Sand _____
	Gas _____
	Oil _____
	Total Depth _____
	PRODUCTION
	1st 24 hrs. Nat. _____
	1st 24 hrs. after shot _____
	Gas _____ Cu. Ft.
	Dry Hole _____
	Abandoned _____

Date 4/27, 1916 Co. J Scout

Map No. _____ Sec. 21 Twp. 28 R. 4
 Well No. 8 Smith Farm _____
Empire Company _____

NORTH

WEST

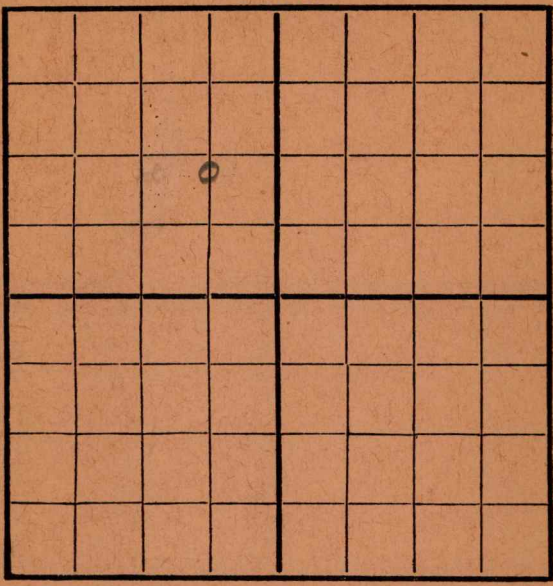

EAST

SOUTH

Location Chung
 Rig Up _____
 Drilling and remarks _____

RECORD

Cased _____ in. _____ Ft.
 Sand _____
 Gas _____
 Oil _____
 Total Depth _____

PRODUCTION

1st 24 hrs. Nat. _____
 1st 24 hrs. after shot _____
 Gas _____ Cu. Ft.
 Dry Hole _____
 Abandoned _____

Date 12/2, 1916, Cord Scout _____


Map No. _____ Sec. 21 Twp. 28 R. 4Well No. 8 Santa Farm _____

Company _____

NORTH

WEST

EAST

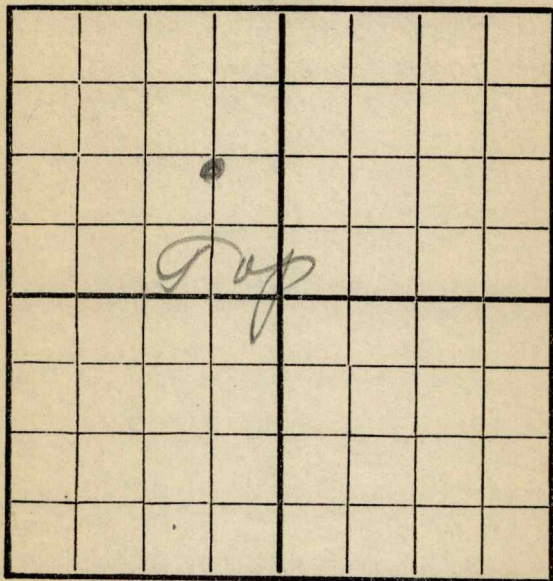

SOUTH

Location _____

Rig Up _____

Drilling and remarks _____

RECORD

Cased _____ in. _____ Ft.

Sand _____

Gas _____

Oil _____

Total Depth _____

PRODUCTION

1st 24 hrs. Nat. _____

1st 24 hrs. after shot _____

Gas _____ Cu. Ft.

Dry Hole _____

Abandoned _____


Date

10/4, 191

6 Cardiff Scout

Map No. _____ Sec. 21 Twp. 28 R. 4
 Well No. E. Smith Farm _____
Empire Company _____

NORTH

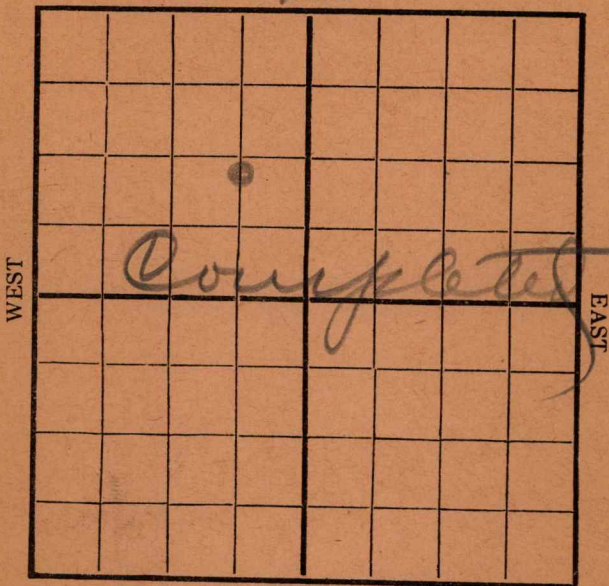

SOUTH

Location _____

Rig Up _____

Drilling and remarks

*Estimated
at 200
Bbls per
day*

RECORD

Cased _____ in. _____ Ft.
 Sand 2460-2484
 Gas _____
 Oil _____
 Total Depth _____

PRODUCTION

1st 24 hrs. Nat. _____
 1st 24 hrs. after shot _____
 Gas _____ Cu. Ft.
 Dry Hole _____
 Abandoned _____

Date

12/11/1916 C. D. King Scout