

Map No. _____ Sec 21 Twp 28 R 4Well No. 10 Smith Farm __________Empire_____
Company

NORTH

WEST

EAST

SOUTH

COMPLETED

Location _____

Rig Up 12/11/16

Drilling Remarks:

Drilling Remarks:

Q 21: 12/18: 12/28
1-8-17 = 758'1130-1/15:

RECORD

PRODUCTION

Cased _____ in _____ Ft.

1st 24 hrs. Nat. _____

Sand _____

1st 24 hrs. after shot _____

Gas _____

Gas _____ Cu. Ft.

Oil _____

Dry Hole _____


Total Depth _____

Abandoned _____

Map No. _____ Sec. 21 Twp. 28 R. 4

Well No. 10 Smith Farm _____
Cumprine Company _____

NORTH

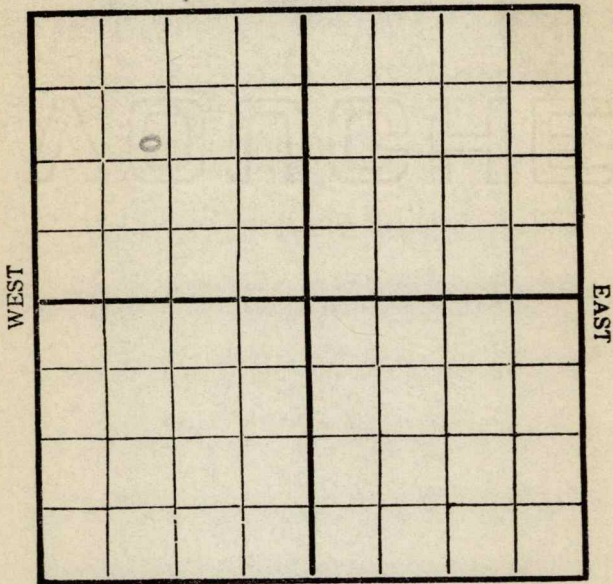

SOUTH

Location _____
 Rig Up _____
 Drilling and remarks _____

RECORD

Cased _____ in. _____ Ft.
 Sand _____
 Gas _____
 Oil _____
 Total Depth _____

PRODUCTION

1st 24 hrs. Nat. _____
 1st 24 hrs. after shot _____
 Gas _____ Cu. Ft.
 Dry Hole _____
 Abandoned _____

Date

10/11, 1916 Candey Scout

Map No. _____ Sec. 21 Twp. 28 R. 4Well No. 10 _____ Farm _____Company Engine _____

NORTH

WEST

EAST

SOUTH

RECORD

Location _____

Rig Up _____

Drilling and remarks _____

Cased _____ in. _____ Ft.

Sand _____

Gas _____

Oil _____

Total Depth _____

PRODUCTION

1st 24 hrs. Nat. _____

1st 24 hrs. after shot _____

Gas _____ Cu. Ft.

Dry Hole _____

Abandoned _____

Date


12/8, 1916 Cardiff Scout

Map No. _____ Sec. 21 Twp. 28 R. 4
 Well No. 10 Smith Farm _____
Empire Company _____

NORTH

WEST

EAST

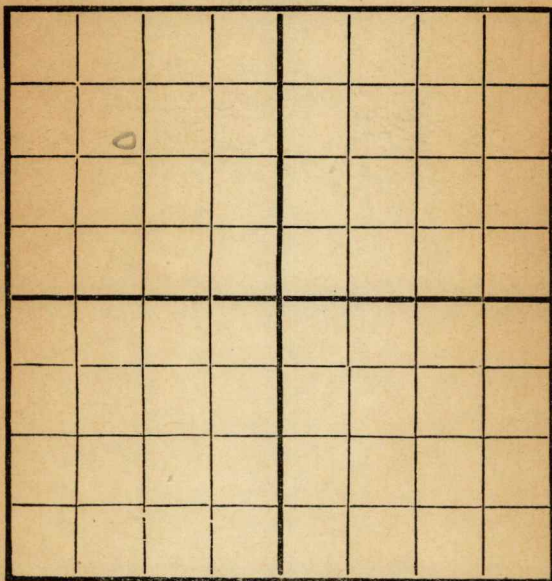

SOUTH

Location _____
 Rig Up _____
 Drilling and remarks _____

RECORD

Cased _____ in. _____ Ft.
 Sand _____
 Gas _____
 Oil _____
 Total Depth _____

PRODUCTION


1st 24 hrs. Nat. _____
 First 24 hrs. after shot _____
 Gas _____ Cu. Ft.
 Dry Hole _____
 Abandoned _____

Date

12/28/6 191 6 _____ Scout

Map No. _____ Sec. 21 Twp. 28 R. 4
 Well No. 10 Smith Farm _____
Engine Company _____

NORTH

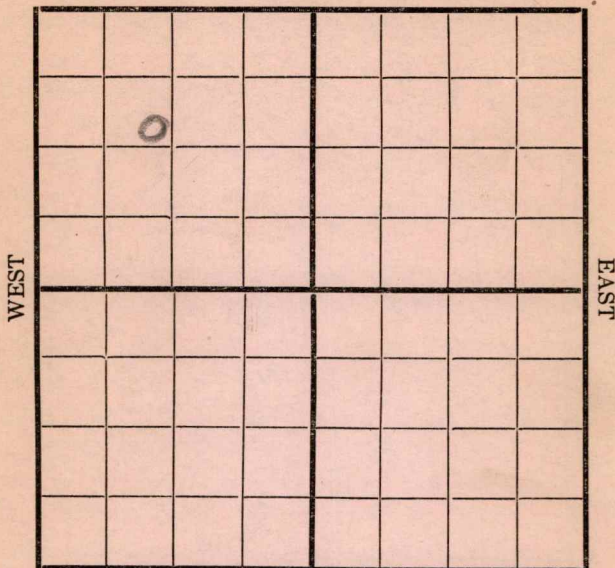

SOUTH

Location _____
 Rig Up ☒ _____
 Drilling and remarks _____

RECORD

Cased _____ in. _____ Ft.
 Sand _____
 Gas _____
 Oil _____
 Total Depth _____

PRODUCTION

1st 24 hrs. Nat. _____
 1st 24 hrs. after shot _____
 Gas _____ Cu. Ft.
 Dry Hole _____
 Abandoned _____

Date

1/1, 191


Scout

Map No. _____ Sec. 21 Twp. 28 R. 4
 Well No. 10 _____ Farm _____
Empire _____ Company _____

NORTH

WEST

EAST

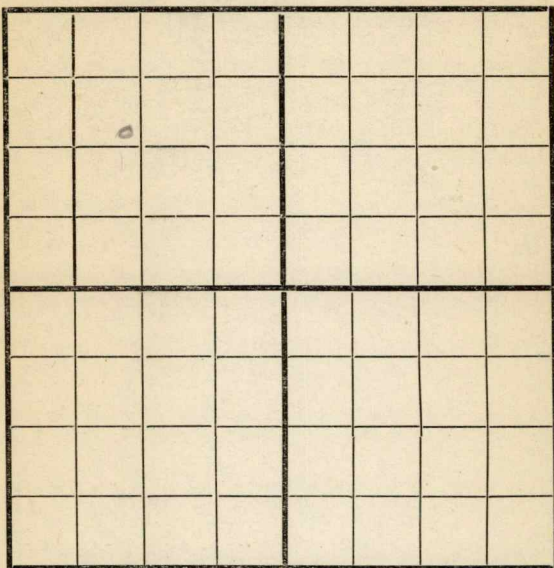

SOUTH

Location _____

Rig Up _____

Drilling and remarks

1290

RECORD

Cased _____ in. _____ Ft.

Sand _____

Gas _____

Oil _____

Total Depth _____

PRODUCTION

1st 24 hrs. Nat. _____

1st 24 hrs. after shot _____

Gas _____ Cu. Ft.

Dry Hole _____

Abandoned _____

Date

1/22, 1917 Carly Scout

Map No. _____ Sec. 21 Twp. 28 R. 4Well No. 10 _____ Farm _____

_____ Company _____

NORTH

WEST

EAST

SOUTH

Location _____

Rig Up _____

Drilling and remarks

1660'

RECORD

Cased _____ in. _____ Ft.

Sand _____

Gas _____

Oil _____

Total Depth _____

PRODUCTION

1st 24 hrs. Nat. _____

1st 24 hrs. after shot _____

Gas _____ Cu. Ft.

Dry Hole _____

Abandoned _____


Date

1/29, 1917 _____ Scout

Map No. _____ Sec. 21 Twp. 28 R. 4
 Well No. 10 _____ Farm _____
Empire _____ Company _____

NORTH

WEST

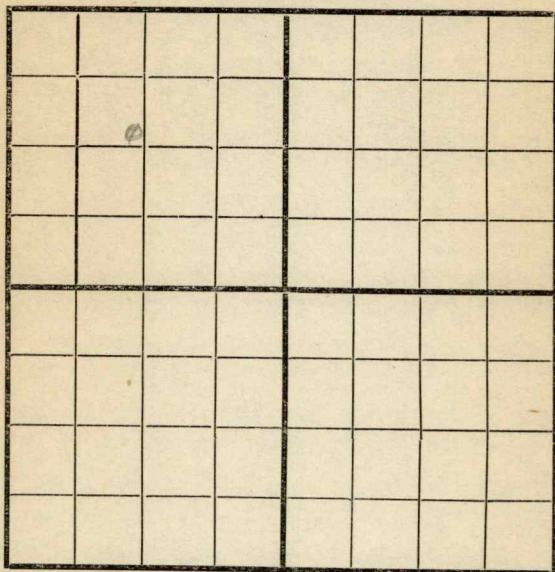

EAST

SOUTH

Location _____

Rig Up _____

Drilling and remarks

1890'

RECORD

Cased _____ in. _____ Ft.

Sand _____

Gas _____

Oil _____

Total Depth _____

PRODUCTION

1st 24 hrs. Nat. _____

1st 24 hrs. after shot _____

Gas _____ Cu. Ft.

Dry Hole _____


Abandoned _____

Date

2/5, 1917 Cordiff Scout

Map No. _____ Sec. 21 Twp. 28 R. 4
 Well No. 10 Smith Farm _____
Cumprine Company _____

NORTH

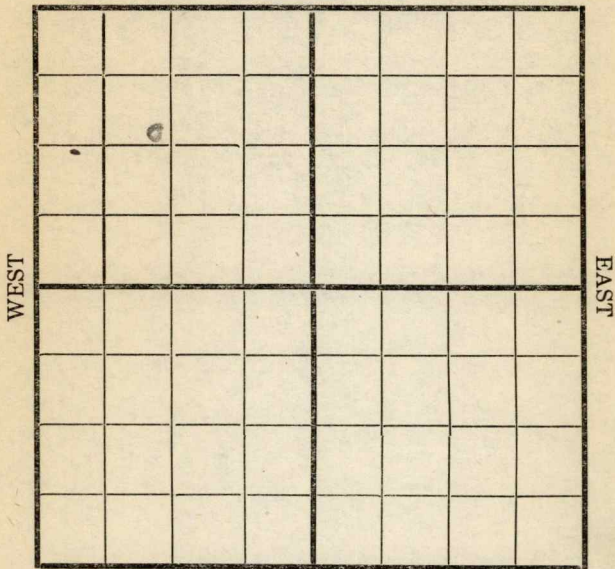

SOUTH

Location _____ Rig Up _____ Drilling and remarks <u>2060</u>	RECORD
	Cased _____ in. _____ Ft.
	Sand _____
	Gas _____
	Oil _____
	Total Depth _____
	PRODUCTION
	1st 24 hrs. Nat. _____
	1st 24 hrs. after shot _____
	Gas _____ Cu. Ft.
	Dry Hole _____
	Abandoned _____

Date 2/12, 1917 Cumprine Scout

Map No. _____ Sec. 21 Twp. 28 R. 4Well No. 10 Smith Farm

_____ Company

NORTH

WEST

EAST

SOUTH

Location _____

Rig Up _____

Drilling and remarks

2150'

RECORD

Cased _____ in. _____ Ft.

Sand _____

Gas _____

Oil _____

Total Depth _____

PRODUCTION

1st 24 hrs. Nat. _____

1st 24 hrs. after shot _____

Gas _____ Cu. Ft.

Dry Hole _____

Abandoned _____

Date

2/19, 1917 Andy Scout


NORTH

WEST

EAST

SOUTH

Location _____

Rig Up _____

Drilling and remarks

2285'

RECORD

Cased _____ in. _____ Ft.

Sand _____

Gas _____

Oil _____

Total Depth _____

PRODUCTION

1st 24 hrs. Nat. _____

First 24 hrs. after shot _____

Gas _____ Cu. Ft.

Dry Hole _____


Abandoned _____

Date

Feb 26 191 2 Curdy Scout

Map No. _____ Sec. 21 Twp. 28 R. 4Well No. 10 Smith FarmCummins Company

NORTH

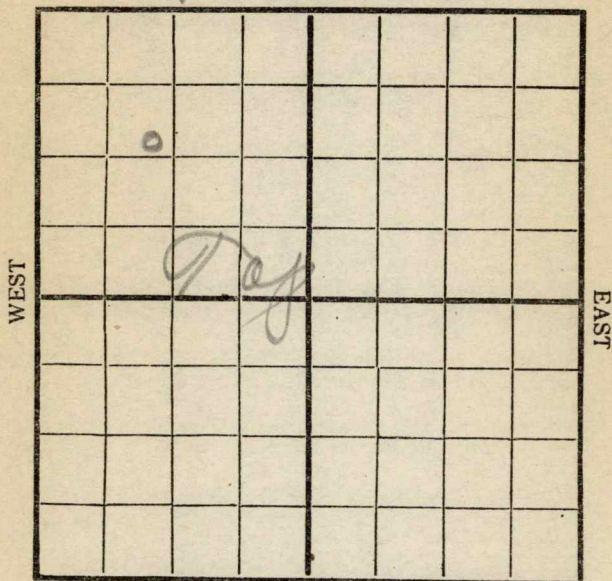

SOUTH

REMARKS:


Tap sand 2469

Date

2/5, 1917 Cord Scout

Map No. _____ Sec. 21 Twp. 28 R. 4
 Well No. 10 Smith Farm _____
Engine Company _____

NORTH

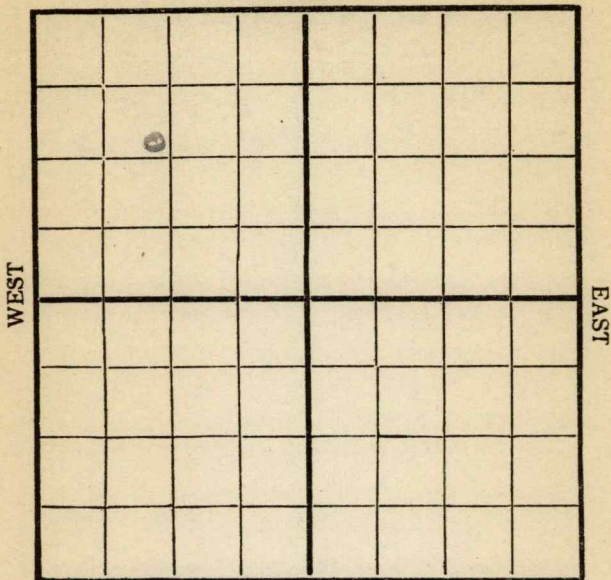

SOUTH

Location _____

Rig Up _____

Drilling and remarks

Top sand
2469
Pulling
Ripe

RECORD

Cased _____ in. _____ Ft.

Sand _____

Gas _____

Oil _____

Total Depth _____

PRODUCTION

1st 24 hrs. Nat. _____

1st 24 hrs. after shot _____

Gas _____ Cu. Ft.

Dry Hole _____

Abandoned _____

Date

3/12, 191 *7* *Conley* Scout

Map No. _____ Sec. 21 Twp. 28 R. 4
 Well No. 10 Smith Farm _____
Empire Company _____

NORTH

WEST

EAST

COMPLETED

SOUTH

Location _____

Rig Up _____

Drilling and remarks

Est at
 150 Bbls

[Handwritten signature]

RECORD

Cased _____ in. _____ Ft.

Sand 2469-2504

Gas _____

Oil _____

Total Depth _____

PRODUCTION

1st 24 hrs. Nat. _____

1st 24 hrs. after shot _____

Gas _____ Cu. Ft.

Dry Hole _____

Abandoned _____

Date

3/19, 1917 Carley Scout