

Cowley

KANSAS

SECTION 5 TOWNSHIP 30 RANGE 5E

WELL NO. #1 Graham

COMPANY Rex & Morris

NORTH

WEST

EAST

SOUTH

0

Cowley

KANSAS

SEC.	TWP.	R.
5	30	5E

WELL NO.

#1 Graham

FARM

COMPANY

Rex & Morris

CONTRACTOR

Combs

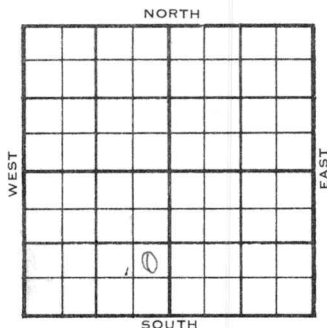
Ft. from N. Line

Ft. from S. Line

Ft. from E. Line

Ft. from W. Line

NE SE SW

SDX $\frac{1}{2}$ mile.

1956	ELEVATION	REPORT
	1296'	

4-18 WOR

4-26 B.Lans. 2118
 KC 2216
 BKC 2456
 Ce. 2667
 Bart. zn. 2784
 Bart. Sd. 2823
 Cherty Cong. 2860
 Miss. 2870
 TD 2878,
 5 $\frac{1}{2}$ " @ 2878'

5-3 WOCT

5-10 No report

5-16 104/2827-53, tst 1 BW, ph + sc.
 FU 2 0' oil + 50' W, 14 hrs.
 Frac, P/ 25 BOPD, no/wtr.
 TD 2878'

COMPLETED

County Cowley Elev. _____
Sec. 5 Twp. 30 Rgs. 5E
Company Rex & Morris
Farm Name Graham No. 1

TOPS	DEPTH	LOG	DATUM	Loc. in Sec.
Anh.				NE SE SW
Tp.				
H.				
Tr.				
Dg.				
B.L.				
L.				Geol.
K.C.				Contr.
B.K.C.				
Ce.				
C.				
M.				
M.				Pool
K.				Combs
Mz.				
Me.				
V.				
S.				
S.				
A.				
R.				
Pe.				
G.				
T.D.				

APR	18	'55
FIRST REPORT		
1/2 mile		

Date Comm. WOR

229

APR 18 1955

R. G.

County Cowley Elev. 1296
 Sec. 5 Twp. 30 Rge. 5E
 Company Rex & Morris
 Farm Name Graham No. 1

	DEPTH	LOG	DATUM	Loc. in Sec.
				NE SE SW
H.				
Tr.				
Dg.				
BL.				
L. <u>Base</u>	<u>2118</u>			
M.C.	<u>2216</u>			Geol.
B.X.C.	<u>2456</u>			Contr.
Ce.	<u>2667</u>			
C. <u>Borthan</u>	<u>2784</u>			
M. <u>" sd</u>	<u>2823</u>			
M. <u>Cherty</u>	<u>2860</u>			Pool
K. <u>Miss</u>	<u>2870</u>			Combs
Mz.				
Mq.				
V.				
S.				
S.				
A.				
R.				
Pe.				
G.				
T.D.	<u>2878</u>			

COMPLETE
 4 mile
 0

Date Comm. MAY 16 1956

APR 25 '56 5 1/2 @ 2878 MAY 2 '56

WOCT MAY 9 '56

MAY 16 '56 104/2827-53 +st +BW
 ph + sc. FU 200' oil + 50' w
 14 hrs Frac P. 25 Bopd
 no/wtr.