


Map No. _____ Sec. 21 Twp. 28 R. 4
 Well No. 3 - Pearson Farm _____
Empire Company _____
 NORTH

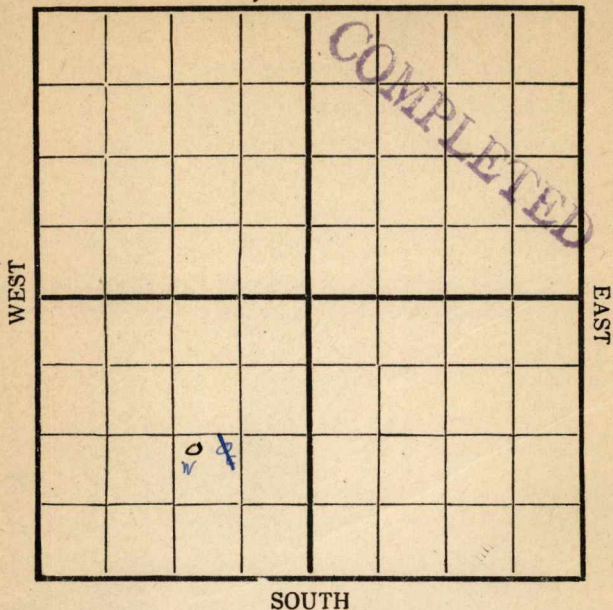

Location _____

Rig Up 9/18/16

Drilling Remarks

Drilling Remarks

9/27 - Spudding
10/2 - 400
10/9 - 840
10/17 - 1715
10/23 - 1900
2060 = 11/9
2230 = 11/14
2510 = 11/27

RECORD

PRODUCTION

Cased _____ in. _____ Ft.

1st 24 hrs. Nat. _____

Sand _____

1st 24 hrs. after shot _____

Gas _____

Gas _____ Cu. Ft.

Oil _____


Dry Hole _____

Total Depth _____

Abandoned 2567

Map No. _____ Sec. 21 Twp. 28 R. 4
 Well No. 3 Rising Farm
Engine Company

NORTH

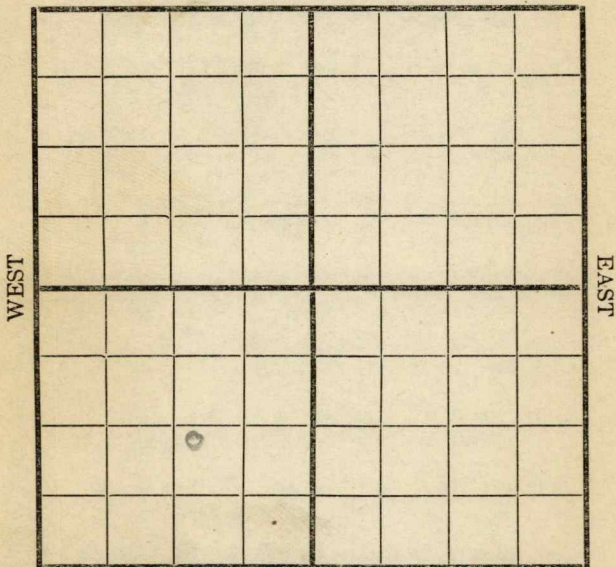

SOUTH

Location ✓
 Rig Up ✓
 Drilling and remarks
1

RECORD

Cased _____ in. _____ Ft.
 Sand _____
 Gas _____
 Oil _____
 Total Depth _____

PRODUCTION

1st 24 hrs. Nat. _____
 1st 24 hrs. after shot _____
 Gas _____ Cu. Ft.
 Dry Hole _____
 Abandoned _____


Date 9/18, 1916 Scout Scout

Map No. _____ Sec. 21 Twp. 28 R. 4
 Well No. 3 _____ Farm _____
Empire _____ Company _____

NORTH

WEST

EAST

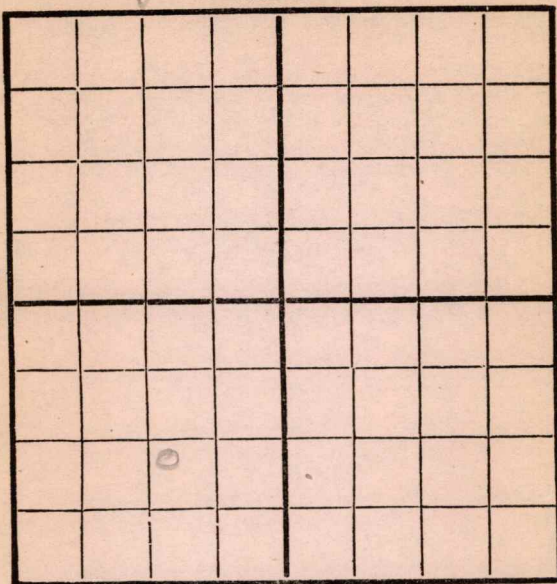

SOUTH

Location _____
 Rig Up _____
 Drilling and remarks _____

Spinning

RECORD

Cased _____ in. _____ Ft.
 Sand _____
 Gas _____
 Oil _____
 Total Depth _____

PRODUCTION

1st 24 hrs. Nat. _____
 First 24 hrs. after shot _____
 Gas _____ Cu. Ft.
 Dry Hole _____
 Abandoned _____

Date


9/27, 1916 Scout

Map No. _____ Sec. 21 Twp. 28 R. 4
 Well No. 31 Farm _____
 _____ Company _____

NORTH

WEST

EAST

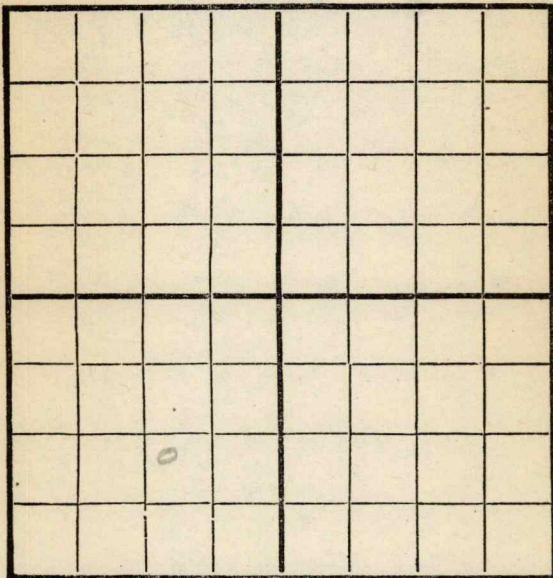

SOUTH

Location _____
 Rig Up _____
 Drilling and remarks _____

RECORD

Cased _____ in. _____ Ft.
 Sand _____
 Gas _____
 Oil _____
 Total Depth _____

PRODUCTION

1st 24 hrs. Nat. _____
 First 24 hrs. after shot _____
 Gas _____ Cu. Ft.
 Dry Hole _____
 Abandoned _____

Date


10/9, 1911 6 L. C. Carley Scout

Map No. _____ Sec. 21 Twp. 28 R. 4
 Well No. 3 Pierson Farm _____
Engine Company _____

NORTH

WEST

EAST

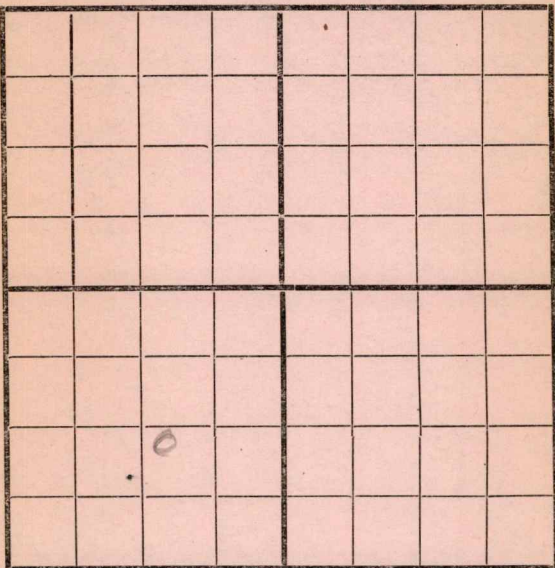

SOUTH

Location _____
 Rig Up _____
 Drilling and remarks

1715

RECORD

Cased _____ in. _____ Ft.
 Sand _____
 Gas _____
 Oil _____
 Total Depth _____

PRODUCTION

1st 24 hrs. Nat. _____
 1st 24 hrs. after shot _____
 Gas _____ Cu. Ft.
 Dry Hole _____
 Abandoned _____

Date


10/17 1916 Stearns Scout

Map No. _____ Sec. 21 Twp. 28 R. 4
 Well No. 3 Russell Farm
Engine Company

NORTH

WEST

EAST

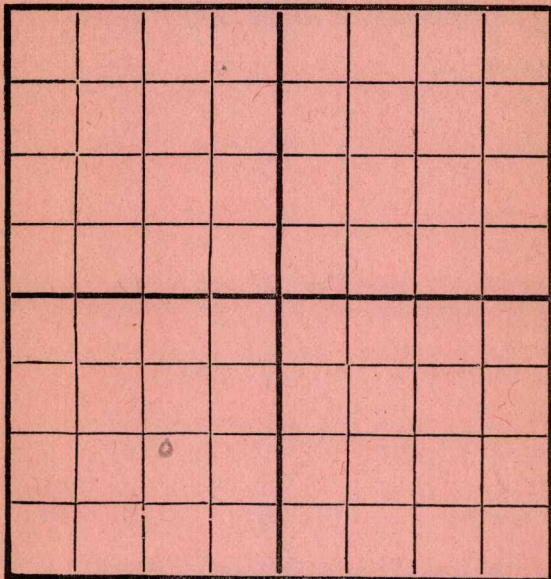

SOUTH

Location _____
 Rig Up _____
 Drilling and remarks

1900

RECORD

Cased _____ in. _____ Ft.
 Sand _____
 Gas _____
 Oil _____
 Total Depth _____

PRODUCTION

1st 24 hrs. Nat. _____
 First 24 h.s. after shot _____
 Gas _____ Cu. Ft.
 Dry Hole _____
 Abandoned _____


Date

10/23 1916 L. C. Jones Scout

Map No. _____ Sec. 21 Twp. 28 R. 4Well No. 3 Rierson Farm_____ Cummins Company

NORTH

WEST

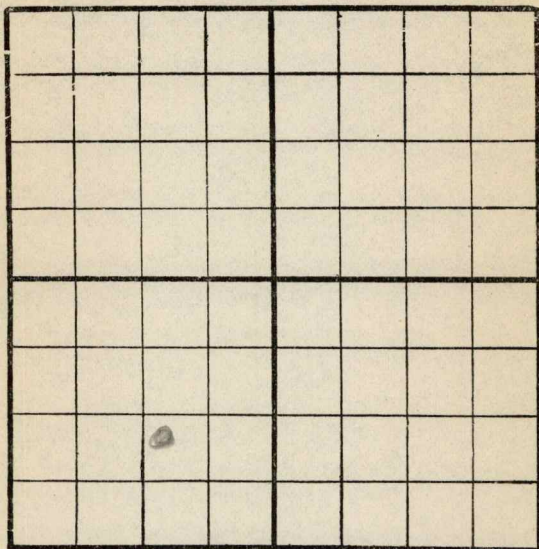

EAST

SOUTH

Location _____

Rig up _____

Drilling and remarks

Top sand
1816

RECORD

Cased _____ in. _____ Ft.

Sand 1816

Gas _____

Oil _____

Total Depth _____

PRODUCTION

1st. 24 hrs. Nat. _____

1st 24 hrs. after shot _____

Gas _____ Cu. Ft.

Dry Hole _____

Abandoned _____

Date


10/301916LEC

Scout

Map No. _____ Sec. 21 Twp. 28 R. 4
 Well No. 3 Reuben Farm _____
Engine Company _____

NORTH

WEST

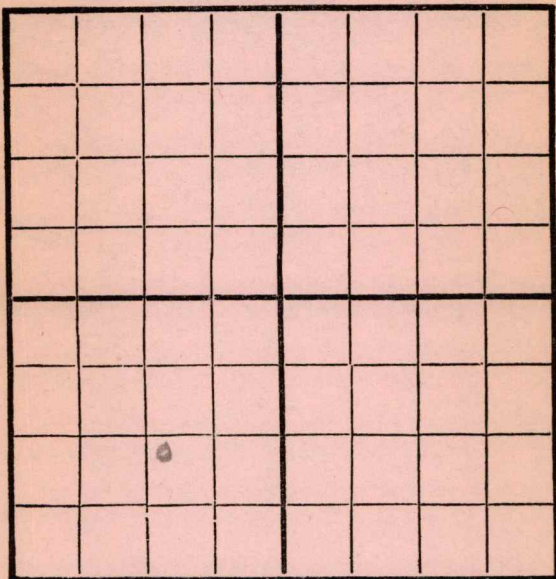

EAST

SOUTH

RECORD

Location _____
 Rig Up _____
 Drilling and remarks

Cased _____ in. _____ Ft.
 Sand 1816-1821
 Gas _____
 Oil _____
 Total Depth _____

PRODUCTION


1st 24 hrs. Nat. _____
 First 24 hrs. after shot _____
 Gas _____ Cu. Ft.
 Dry Hole _____
 Abandoned _____

Date

11/9, 1916 Reuben Scout

Map No. _____ Sec. 21 Twp. 28 R. 4
 Well No. 3 _____ Farm _____
 _____ Company

NORTH

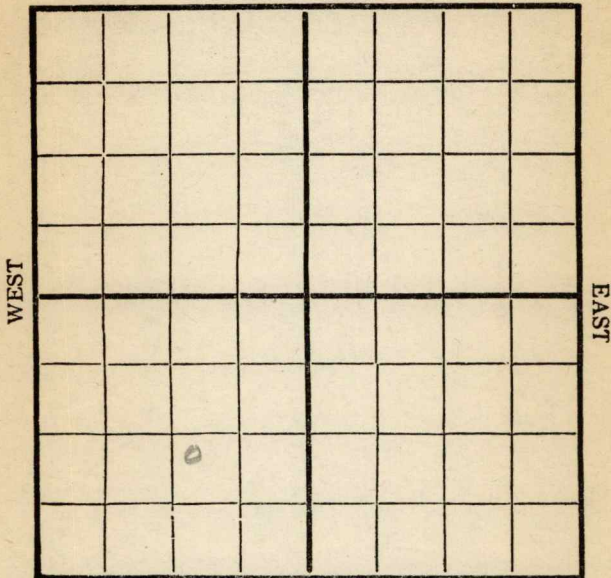

SOUTH

Location _____
 Rig Up _____
 Drilling and remarks

2230

RECORD

Cased _____ in. _____ Ft.
 Sand _____
 Gas _____
 Oil _____
 Total Depth _____

PRODUCTION


1st 24 hrs. Nat. _____
 First 24 hrs. after shot _____
 Gas _____ Cu. Ft.
 Dry Hole _____
 Abandoned _____

Date

1/14, 1916 Carroll Scout

Map No. _____ Sec. 21 Twp. 28 R. 4
Well No. 3 Pearson Farm _____
Engine Company _____

NORTH

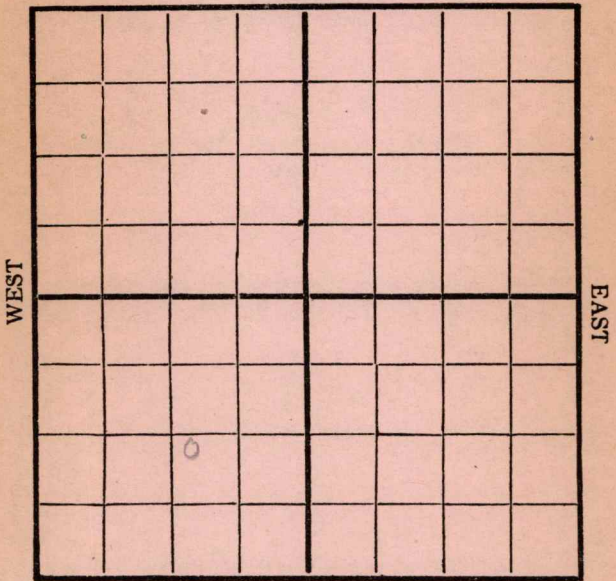

SOUTH

Location _____
Rig Up _____
Drilling and remarks
2510

RECORD

Cased _____ in. _____ Ft.
Sand _____
Gas _____
Oil _____
Total Depth _____

PRODUCTION


1st 24 hrs. Nat. _____
1st 24 hrs. after shot _____
Gas _____ Cu. Ft.
Dry Hole _____
Abandoned _____

Date 11/20 1916 C. Condy Scout

Map No. _____ Sec. 21 Twp. 28 R. 4
Well No. 3 _____ Farm _____
Burns _____ Company _____

NORTH

WEST

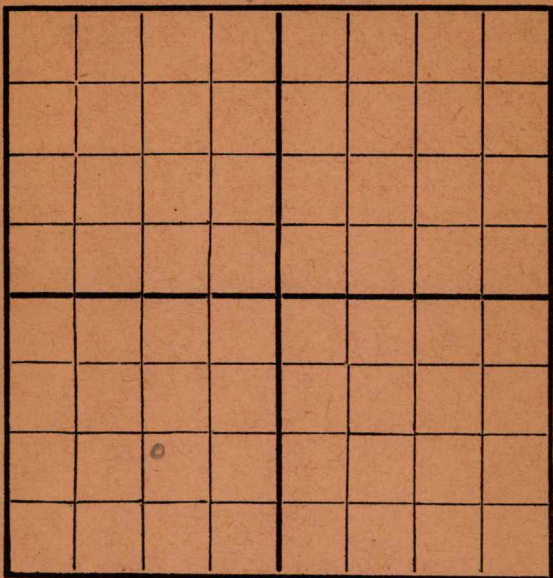

EAST

SOUTH

Location _____
Rig Up _____
Drilling and remarks _____

2510
Shut Down

RECORD

Cased _____ in. _____ Ft.
Sand _____
Gas _____
Oil _____
Total Depth _____

PRODUCTION


1st 24 hrs. Nat. _____
1st 24 hrs. after shot _____
Gas _____ Cu. Ft.
Dry Hole _____
Abandoned _____

Date _____
11/27, 1916 _____ Scout _____

Map No. _____ Sec. 21 Twp. 28 R. 4Well No. 3 Rieson FarmEngine Company

NORTH

WEST

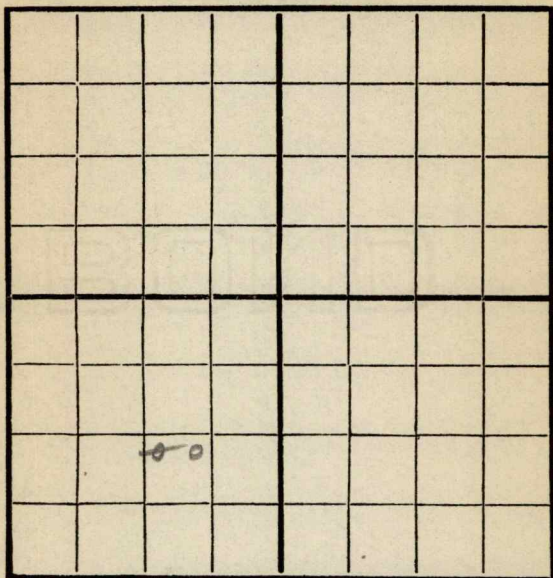

EAST

SOUTH

Location Changel

Rig Up _____

Drilling and remarks _____

RECORD

Cased _____ in. _____ Ft.

Sand _____

Gas _____

Oil _____

Total Depth _____

PRODUCTION

1st 24 hrs. Nat. _____

1st 24 hrs. after shot _____

Gas _____ Cu. Ft.

Dry Hole _____

Abandoned _____


Date

12/2, 1916, Cauldy Scout

Map No. _____ Sec. 21 Twp. 28 R. 4Well No. 3 Rierson Farm
Engine Company

NORTH

WEST

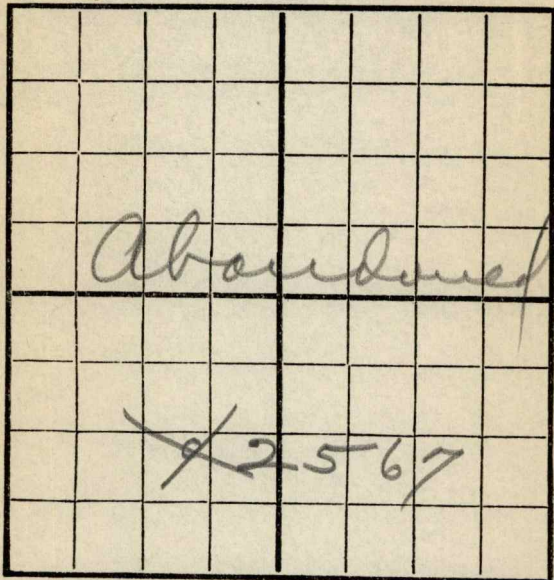

EAST

SOUTH

Location _____

Rig Up _____

Drilling and remarks

RECORD

Cased _____ in. _____ Ft.

Sand _____

Gas _____

Oil _____

Total Depth _____

PRODUCTION

1st 24 hrs. Nat. _____

1st 24 hrs. after shot _____

Gas _____ Cu. Ft.

Dry Hole _____

Abandoned _____

Date

12/4, 1916, Cord Scout

MAP NO. KANSAS SEC. 21 TWP. 28S R. 4E

WELL NO. 3 Reeson

Empire COMPANY

CONTRACTOR

SECTION PLAT

ABANDONED

_____ FT. FROM N. LINE

_____ FT. FROM S. LINE

_____ FT. FROM E. LINE

_____ FT. FROM W. LINE

LOCATION _____

RIG UP _____

DRILLING AND REMARKS:

RECORD

CASED _____ IN. _____ FT.

SAND _____

GAS _____

OIL _____

TOTAL DEPTH 2567

PRODUCTION

1ST 24 HRS. NAT. _____

1ST 24 HRS. AFTER SHOT _____

GAS _____ CU. FT.

DRY HOLE ✓

ABANDONED ✓

DATE

12-6 1926 SCOUT