

Cowley

KANSAS

SECTION 5 TOWNSHIP 30 RANGE 5E

WELL NO. #3 Graham

COMPANY Rex & Morris & Gross Drlg.

NORTH

	0						

SOUTH

WEST

EAST

SEC. 5	TWP. 30 S	R. 5 E
-----------	--------------	-----------

WELL NO.

3 Graham

FARM

COMPANY

Rex & Morris & Gross Drlg.

CONTRACTOR

Co. tools


Combs

_____ FT. FROM N. LINE

_____ FT. FROM S. LINE

_____ FT. FROM E. LINE

_____ FT. FROM W. LINE

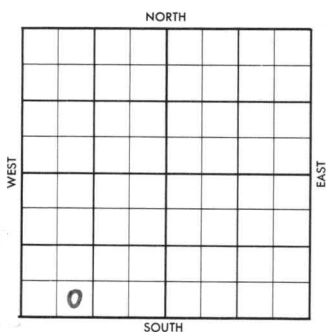

SE SW SW

SDX - 1/4 Mile

SDX - 1/2 Interest in Lease

ELEVATION

REPORT

1957

1/16

MIR

County Cowley Elev. _____
Sec. 5 Twp. 30 Rgs. 5E
Company Rex & Morris & Cross Drlg.
Farm Name Graham No. 3

TOPS	DEPTH	LOG	DATUM	Loc. in Sec.
Anh.				SE SW SW
TP.				
H.				
Tr.				
Dg.				
BL.				
L.				Geol.
K.C.				Contr.
B.K.C.				
Ce.				Co. tools
C.				Pool
M.				Combs
M.				
K.				
Mz.				
Me.				
V.				
S.				
S.				
A.			SDX	1/4 Mile
R.				
PE.			SDX	1/2 int. lease
G.				
T.D.				

FIRST REPORT

JAN 16 '57

Date Comm. M I R

29

1001 15 1946

M.M.

County Cowley Elev. 1281
 Sec. 5 Twp. 30 Rgs. 5E
 Company Rex & Morris & Gross Drlg.
 Farm Name Graham No. 3

Co.

Lse.

No.

Sec.

T.

R.

DEPTH LOG DATUM

Loc. in Sec.

SE SW SW

Geol.

Contr.

Co. tools

Pool

Combs

COMPLETE

1/4 mile

1/2 int / 1000

FEB 27 '57

Tr.
Dg.
Bl.
L.
K.C.
B.K.C.
Ce.
C.
M.
M.
K.
Mz.
Ma.
V.
S.
A.
R.
Pe.
G.

TD

2870

Date Comm.

M I R JAN 23 '57 - 1-16-57 85/8102

175 5 1/2 @ 2870 / 75 WOCT JAN 30 '57

PF 2816-46 FU 350' oil

+ 250' SW 12 hrs FRAC FEB 6 '57

\$ 60 Bq + 20 BW 3 hrs

POA FEB 13 '57 / FEB 20 '57 ✓ FEB 27 '57 + P.

50 Bopd + 200 BWpd

P. 25 Bopd + 100 BWpd