


Cowley

KANSAS

SECTION 6 TOWNSHIP 30S RANGE ~~36~~ 5E

WELL NO. #1 Abilgarrel (*Abildgaard*)

COMPANY Bedell & Catt

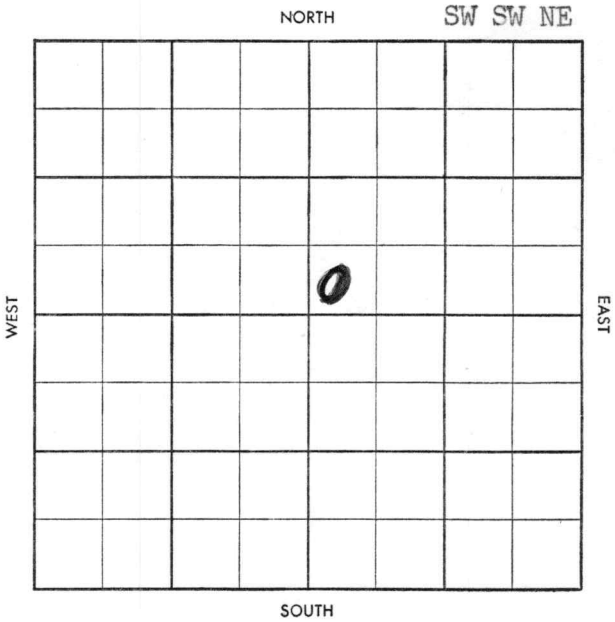

WILDCAT

S-513-B

County Cowley Elev. _____
 Sec. 6 Twp. 30 Rge. 5E
 Company Bedell & Catt
 Farm Name Abilgarrel No. 1

TOPS	DEPTH	LOG	DATUM
Anh.			
Tp.			
H.			
Tr.			
Dg.			
B.L.			
L.			
K.C.			
B.K.C.			
Ce.			
C.			
M.			
M.			
K.			
Mz.			
Mq.			
V.			
S.			
S.			
A.			
R.			
Pf.			
G.			
T.D.			

Loc. in Sec. _____

SW SW NE

Geol. _____

Contr. _____

Co. Tools

Pool _____

Wildcat

FIRST REPORT

FEB 26 '58

Date Comm. _____

8" @ 150, MIRT

Co.

Lse.

No.

Sec.

T.

R.

5-513-B

Co.

County Cowley Elev. 12770' 12720'
 Sec. 6 Twp. 30 Rge. 5E
 Company Bedell & Catt
 Farm Name Abilgarrel No. 1

TOPS	DEPTH	LOG	DATUM
Anh.			
Tp.			
H.			
Tr.			
Dg.			
B.L.			
L.			
K.C.	2231		
B.K.C.	2471		
Ce.	2555		
C.	2649		
M.	2806-12		
M.	2870		
K.			
Mz.			
Mq.			
V.			
S.			
S.			
A.			
R.			
Pf.			
G.			
I.D.	2900		

Loc. in Sec. SW SW NE

Geol. X
 Contr. Co. Tools

Pool Wildcat

ABANDONED

MAR 12 '58

Sec.

No.

Sec.

T.

R.

Date Comm. 2-25-58

8" @ 120, MIRT DST 2801-14

45" 10' n BHP 265/45"

FP 45-50 MAR 12 '58 DST 2876-85

60" 30' 50 CM 60 WM BHP 1100-

1000/30" FP 25-65

DBA