


Map No. \_\_\_\_\_ Sec. 21 Twp. 28 R. 4Well No. 32 J W Smyth Farm \_\_\_\_\_  
Cent Oil & Gas Company \_\_\_\_\_

NORTH

WEST

EAST

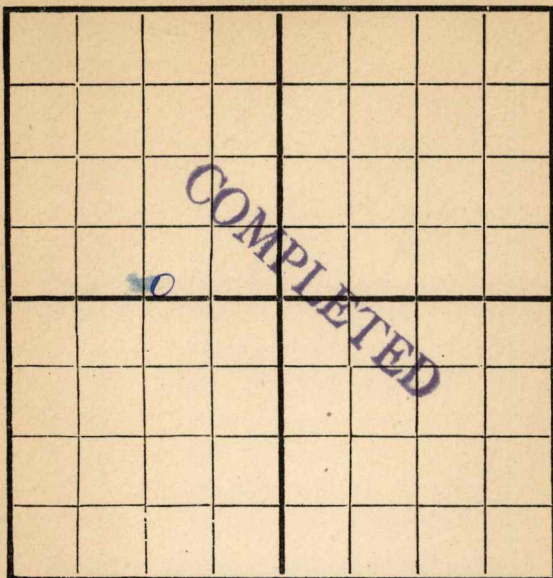

SOUTH

Location \_\_\_\_\_

Rig Up \_\_\_\_\_

Drilling Remarks:

Drilling Remarks:

5/22 2250 fishing

## RECORD

Cased \_\_\_\_\_ in \_\_\_\_\_ Ft.

Sand \_\_\_\_\_

Gas \_\_\_\_\_

Oil \_\_\_\_\_

Total Depth \_\_\_\_\_

## PRODUCTION

1st 24 hrs. Nat. \_\_\_\_\_


1st 24 hrs. after shot \_\_\_\_\_

Gas \_\_\_\_\_ Cu. Ft.

Dry Hole \_\_\_\_\_

Abandoned \_\_\_\_\_

Map No. \_\_\_\_\_ Sec. 21 Twp. 28 R. 4  
Well No. 3 Smith Farm  
Michilena Natural Company

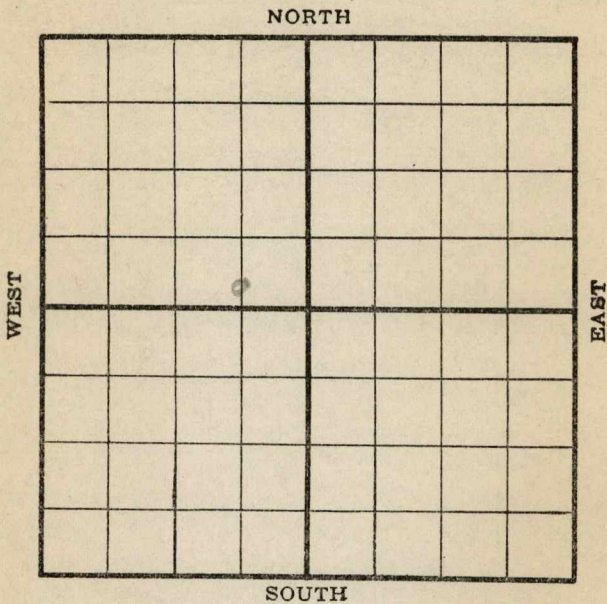

Location \_\_\_\_\_  
Rig up \_\_\_\_\_  
Drilling and remarks

1340 ft

RECORD

Cased \_\_\_\_\_ in. \_\_\_\_\_ Ft.  
Sand \_\_\_\_\_  
Gas \_\_\_\_\_  
Oil \_\_\_\_\_  
Total Depth \_\_\_\_\_

PRODUCTION

1st 24 hrs. Nat. \_\_\_\_\_  
1st 24 hrs. after shot \_\_\_\_\_  
Gas \_\_\_\_\_ Cu. Ft.  
Dry Hole \_\_\_\_\_  
Abandoned \_\_\_\_\_


Date 4/6, 1916, Kirkland Scout

Map No. \_\_\_\_\_ Sec. 21 Twp. 28 R. 4Well No. 3 lv Smith Farm \_\_\_\_\_Oil & Gas Company \_\_\_\_\_

NORTH

WEST

EAST

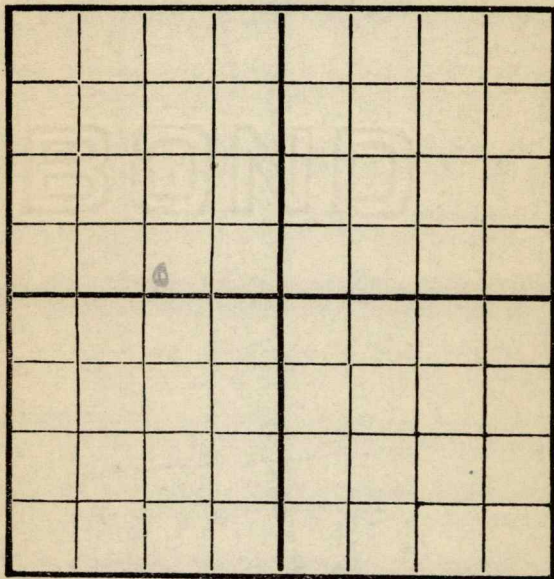

SOUTH

Location \_\_\_\_\_

Rig Up \_\_\_\_\_

Drilling and remarks

2400 ft

## RECORD

Cased \_\_\_\_\_ in. \_\_\_\_\_ Ft.

Sand \_\_\_\_\_

Gas \_\_\_\_\_

Oil \_\_\_\_\_

Total Depth \_\_\_\_\_

## PRODUCTION

1st 24 hrs. Nat. \_\_\_\_\_

1st 24 hrs. after shot \_\_\_\_\_

Gas \_\_\_\_\_ Cu. Ft.

Dry Hole \_\_\_\_\_

Abandoned \_\_\_\_\_


Date

May 12, 1916 Scout

Map No. \_\_\_\_\_ Sec. 21 Twp. 28 R 4  
 Well No. 38m Smith Farm \_\_\_\_\_  
Cont 025 Company \_\_\_\_\_

NORTH

WEST

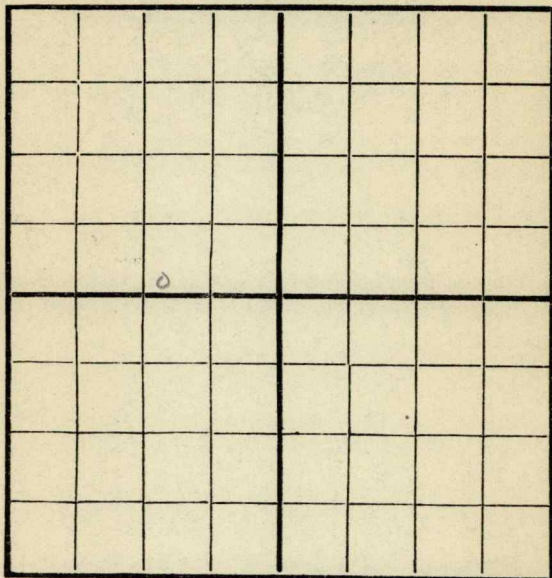

EAST

SOUTH

Location \_\_\_\_\_  
 Rig Up \_\_\_\_\_  
 Drilling and remarks \_\_\_\_\_

*Fishing for holes*  
*Correction: only*  
*2250'*

RECORD

Cased \_\_\_\_\_ in. \_\_\_\_\_ Ft.  
 Sand \_\_\_\_\_  
 Gas \_\_\_\_\_  
 Oil \_\_\_\_\_  
 Total Depth \_\_\_\_\_

PRODUCTION

1st 24 hrs. Nat. \_\_\_\_\_  
 1st 24 hrs. after shot \_\_\_\_\_  
 Gas \_\_\_\_\_ Cu. Ft.  
 Dry Hole \_\_\_\_\_  
 Abandoned \_\_\_\_\_

Date


5/22, 1916 Blairiff Scout

ap No. \_\_\_\_\_ Sec. 21 Twp. 28 R. 4  
 Well No. 3 Farm \_\_\_\_\_  
 \_\_\_\_\_ Company \_\_\_\_\_

NORTH

WEST

EAST

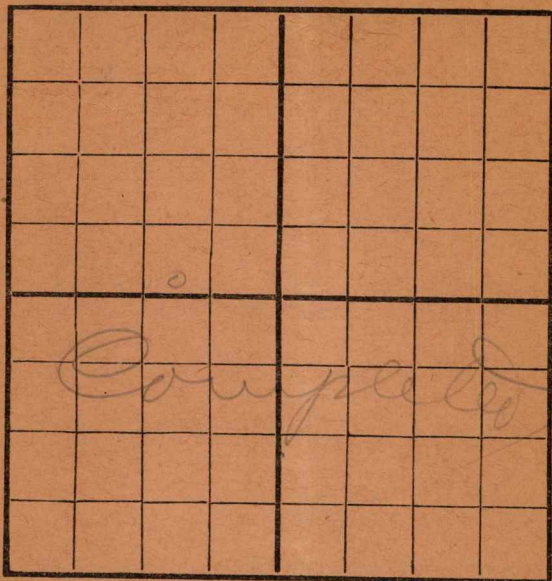

SOUTH

Location \_\_\_\_\_  
 Rig Up \_\_\_\_\_  
 Drilling and remarks \_\_\_\_\_

A fair well

## RECORD

Cased \_\_\_\_\_ in. \_\_\_\_\_ Ft.  
 Sand 2326-2342  
 Gas \_\_\_\_\_  
 Oil \_\_\_\_\_  
 Total Depth \_\_\_\_\_

## PRODUCTION

1st 24 hrs. Nat. \_\_\_\_\_  
 1st 24 hrs. after shot \_\_\_\_\_  
 Gas \_\_\_\_\_ Cu. Ft.  
 Dry Hole \_\_\_\_\_  
 Abandoned \_\_\_\_\_

Date

6/28, 1916 L. L. Lamb Scout


Map No. \_\_\_\_\_ Sec. 21 Twp. 28 R. 4Well No. 3 J W Smith Farm \_\_\_\_\_

Company \_\_\_\_\_

NORTH

WEST

EAST

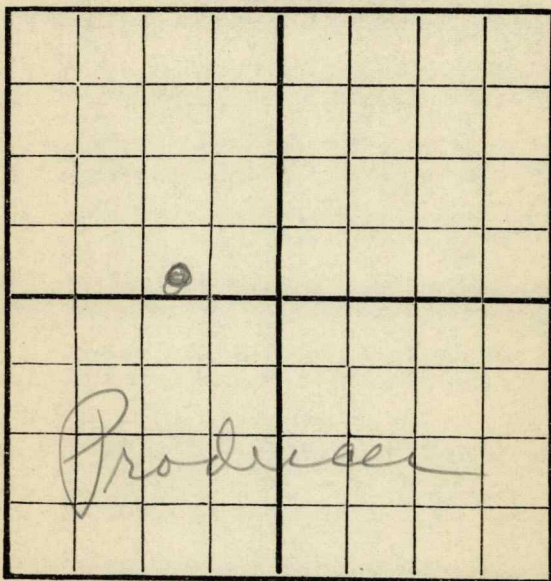

SOUTH

Location \_\_\_\_\_

Rig Up \_\_\_\_\_

Drilling and remarks

*Tip sand*  
*2455*  
*✓*

## RECORD

Cased \_\_\_\_\_ in. \_\_\_\_\_ Ft.

Sand \_\_\_\_\_

Gas \_\_\_\_\_

Oil \_\_\_\_\_

Total Depth \_\_\_\_\_

## PRODUCTION

1st 24 hrs. Nat. \_\_\_\_\_

1st 24 hrs. after shot \_\_\_\_\_

Gas \_\_\_\_\_ Cu. Ft.

Dry Hole \_\_\_\_\_

Abandoned \_\_\_\_\_

Date

*6/30*, 191*6* *Scout* Scout