

KANSAS

Butler


Section 21 Township 28 Range 4E

Well No. 45 A. Smith

Company Cities Service

Misc.

NORTH

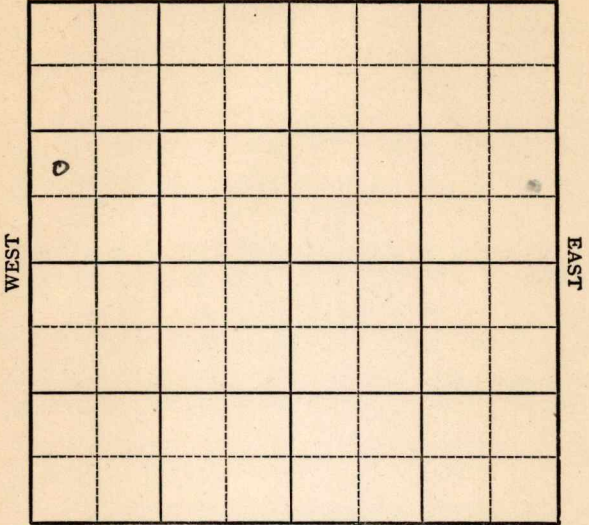

SOUTH

KANSAS

Butler



Sec. 21 Twp. 28 R. 4E

Well No. #46 A. Smith Farm

Cities Service Company

Miscellaneous


_____ Ft. from N. Line

990' Ft. from S. Line

_____ Ft. from E. Line

385' Ft. from W. Line

NW SW NW

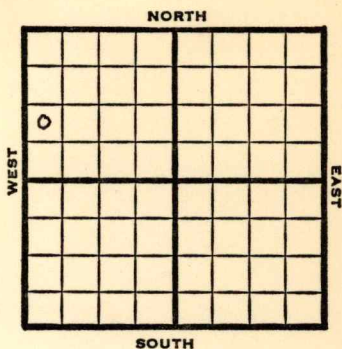

1949

REPORT

3/16 8" @ 90'
Drlg. 1230'

3/23 **Simp 2455'**
Arb 2467-69'
TD 2469'
Run csg.

3/30 5" @ 2457'

4/6 TD 2475'
Arb. 2467'
5"@ 2457'
Pump 27 Oil Pot
38° Gr.
Comp

COMPLETED

Map No. _____ Sec. 21 Twp. 28 R. 4E

Well No. 45 A. Smith

Cities Service Company

FIRST REPORT Contractor

NW SW NW

SECTION PLAT

_____ Ft. from N. Line

990 Ft. from S. Line

_____ Ft. from E. Line

385 Ft. from W. Line

o			

Butler County

Location _____

Rig up _____

Drilling and Remarks:

8" @ 90

drlg. 1230

RECORD

Cased _____ in., _____ ft.

Sand _____

Gas _____

Oil _____

Total Depth _____

PRODUCTION

1st 24 hrs. Nat. _____

1st 24 hrs. after shot _____

Gas _____ Cu. Ft.

Dry Hole _____

Abandoned _____

Date

MAR 16 1949

19

S. J. LEWIS

Scout

Kansas

Map No. Sec. 21 Twp. 28 R. 4E

Well No. 45 A Smith

Cities Service Company
COMPLETE Contractor

NW SW NW

SECTION PLAT

 Ft. from N. Line
990 Ft. from S. Line
 Ft. from E. Line
385 Ft. from W. Line

o			

Butler County

Location
Rig up
Drilling and Remarks:

Cor 2467
5" C 2457
Pump 27 oil
08-4

RECORD

Cased in., ft.
Sand
Gas
Oil
Total Depth 2475

PRODUCTION

1st 24 hrs. Nat.
1st 24 hrs. after shot
Gas Cu. Ft.
Dry Hole
Abandoned

Date

APR 6 1949 19

S. J. LEWIS Scout















Butler County

RECORD

Cased in _____ ft
 Sand _____
 Gas _____
 Oil _____
 Total Depth _____

Location _____
 Rig no. _____
 Drilling and Remarks: _____

Scout Cards	<i>Smith</i>
Land Small Map	
Land Wall Map	
Tracings	<i>SA</i>
France Map	
Pierce Map	<input checked="" type="checkbox"/>
Misc.	

Date