


Cowley

KANSAS

SECTION 5 TOWNSHIP 30 RANGE 5E

WELL NO. #1 Insurance

COMPANY Kewanee Oil

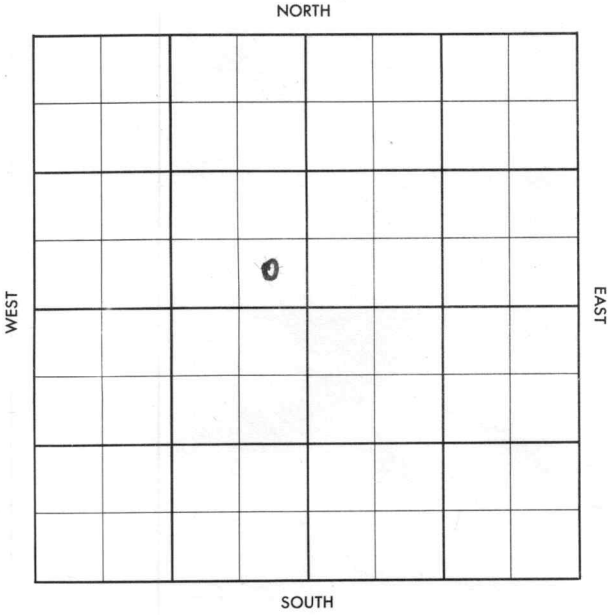

Cowley

KANSAS

SEC. 5	TWP. 30	R. 5E
-----------	------------	----------

WELL NO.

#1 Insurance

FARM

COMPANY

Kewanee Oil

CONTRACTOR

Rex-~~E~~ Morris

Combs


Ft. from N. Line

Ft. from S. Line

Ft. from E. Line

Ft. from W. Line

SE SE NW

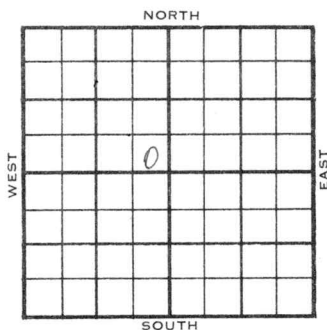

1956

ELEVATION

1295 DF

REPORT

4-25

MIR

5-2

Comm. 4-25-56

8 5/8" @ 150 w/100

DST 2205-32 op 1 hr. rec. 4' mud,
BHP 65/20"

Cored 2800-34 full rec.

Cored 2834-65, full rec.

D & A

Log tops:

KC 2206

BKC 2446

Bartl Zn. 2782

C. 2849

M. 2855

TD 2910'

ABANDONED

County Cowley Elev. 1295 DF
 Sec. 5 Twp. 30 Rgn. 5E
 Company Kewanee Oil
 Farm Name Insurance No. 1

TOPS	DEPTH	LOG	DATUM	Loc. in Sec.
Anh.				SE SE NW
Tr.				
H.				
Tr.				
Dg.				
Bl.				
L.		2206	911	Geol.
K.C.		2446	1151	Contr.
B.K.C.		2782	1487	Rex & Morris
Ce. <u>Bartl 20</u>		2849	1554	
C.		2855	1560	
M.				Pool
M.				Combs
K.				
Mz.				
Mq.				
V.				
S.				
S.				
A.				
R.				
P.E.				
G.				
T.D.	2910			

MAY 2 1956

Date Comm.

M I R

MAY 2 '56

4-25-56 85/8

150/100 DST 2205-32 1hr

rec 4' Md BHP 65/20" crd 2800

-34 Full rec crd 2834-65 Full rec

D E A