
Cowley

KANSAS

SECTION 8 TOWNSHIP 30 RANGE 5E

WELL NO. #1 Holt

COMPANY Rex & Morris Drlg.

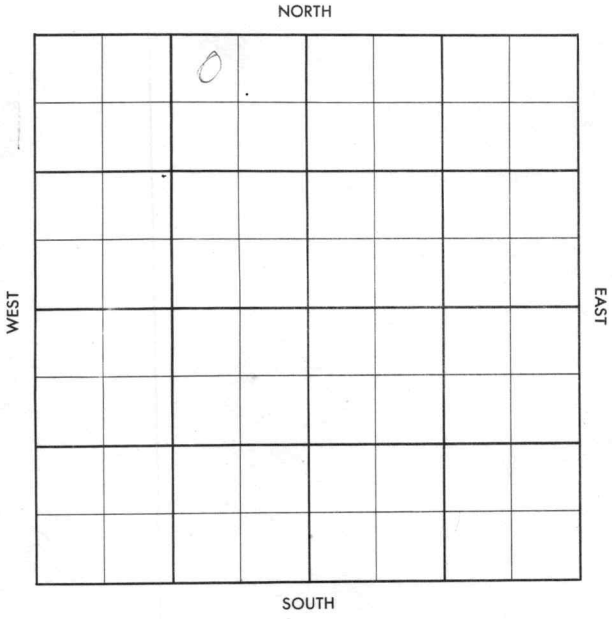

FORM 504-3 SUNRAY

FORM 513 SUNRAY

County Cowley Elev.

Sec. 8 Twp. 30 Rge. 5E

Company Rex & Morris Drlg.

Farm Name Holt No. 1

TOPS	DEPTH	LOG	DATUM
Anh.			
Tp.			
H.			
Tr.			
Dg.			
Bl.			
L.			
K.C.			
B.K.C.			
Ce.			
C.			
M.			
M.			
K.			
Mz.			
Mq.			
V.			
S.			
S.			
A			
R.			
P€.			
G.			
T.D.			

Loc. in Sec. NW NE NW

Geol.

Contr. Co. tools

Pool Combs



Date Comm. R U R

Co. Lse. No. Sec. T. R.

29

FORM 513 SUNRAY

County Cowley Elev. 1294 Co.

Sec. 8 Twp. 30 Rge. 5E

Company Rex & Morris Drlg.

Farm Name Holt No. 1

TOPS	DEPTH	LOG	DATUM
Anh.			
Tp.			
H.			
Tr.			
Dg.			
B.L.			
L.			
K.C.	2224		
B.K.C.	2458		
Ce.			
C. Bartlesville	2795		
M.	2866		
M.			
K.			
Mz.			
Mo.			
V.			
S.			
S.			
A			
R.			
P€.			
G.			
T.D.	2869		


Loc. in Sec. NW NE NW

Geol.

Contr. Co. tools

Lse.

Pool Combs

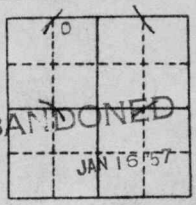

No.

Date Comm.

RUR JAN 9 '57 1-4-57 8 5/8 97

D 2405 JAN 16 '57 cmd 2830-69 nec

39.

DEA

Sec.

T.

R.