

Section 8 Township 30 Range 5 E

Well No. # 1 Kennedy

Company Shields Oil Prod.

NORTH

							0

WEST

EAST

SOUTH

Sec. 8 Twp. 30 R. 5E

Well No. #1 Kennedy Farm

Shield Oil Prod. Company

Rex & Morris Contractor

Semi-Wildcat


330 Ft. from N. Line

Ft. from S. Line

330 Ft. from E. Line

Ft. from W. Line

NE NE SE

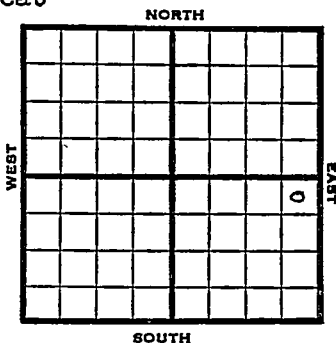

1952 Elev. 1286' REPORT

11/18 Location

12/3 Spud 11-20-52

D&A

TD 2905

8" @ 98

B KC 2464, Prue 2576, Miss 2880

TD 2905

D&A

ABANDONED

