

Cowely

KANSAS


FORM 51 25M 3-49 PETROL

Section 8 Township 30 Range 5E

Well No. #1 Swope

Company Keewanee Oil

NORTH

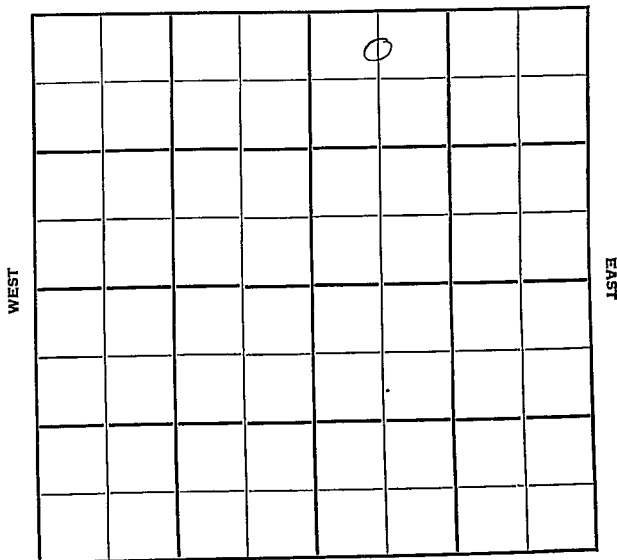

SOUTH

Cowley KANSAS

Sec. 8 Twp. 30 R. 5E ✓

Well No. #1 Swope Farm

Keewanee Oil Company


Miscellaneous (Rex & Morris, Contr.)

330' Ft. from N. Line

 Ft. from S. Line

 Ft. from E. Line

660' Ft. from W. Line

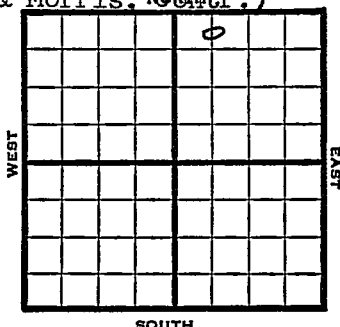

C N L NW NE

1950

Elev 1296'

R E P O R T

1/11

RUR

2/8

TD 2893'

15" @ 357'

10" set 1665'

8" set 2115'

7" set 2439'

TD 2893' in Miss

D&A

Aband.

ABANDONED

Kansas

Miscellaneous

Map No. _____ Sec. 8 Twp. 30 R. 5EWell No. 1: Swope

_____ Keewanee Oil _____ Company

_____ Rex & Morris _____ Contractor

C N L NW NE

SECTION PLAT

330 Ft. from N. Line

_____ Ft. from S. Line

_____ Ft. from E. Line

660 Ft. from W. Line

		o	
FIRST REPORT			

Cowley County

Location _____

Rig up _____

Drilling and Remarks:

R U R

RECORD

Cased _____ in., _____ ft.

Sand _____

Gas _____

Oil _____

Total Depth _____

PRODUCTION

1st 24 hrs. Nat. _____

1st 24 hrs. after shot _____

Gas _____ Cu. Ft.

Dry Hole _____

Abandoned _____

Date

JAN 11 1950

19

J. E. TYRA Scout

Kansas

Map No. _____ Sec. 8 Twp. 30 R. 5EWell No. 1 Swope

_____ Kewanee Oil _____ Company

_____ Contractor

C N L NW NE

E1. 1296
SECTION FLAT330 Ft. from N. Line

_____ Ft. from S. Line

_____ Ft. from E. Line

660 Ft. from W. Line

Cowley County

Location _____

Rig up _____

Drilling and Remarks:

15" @ 35710" @ 16658" @ 21157" @ 2439T.D. 2893 in mudD & A.

RECORD

Cased _____ in, _____ ft.

Sand _____

Gas _____

Oil _____

Total Depth 2893

PRODUCTION

1st 24 hrs. Nat. _____

1st 24 hrs. after shot _____

Gas _____ Cu. Ft.

Dry Hole _____

Abandoned _____

Date

FEB 8 195019J. E. TYRA Scout