

KANSAS


FORM 51 5M 4-41 PETROL

Cowley

Section 12 Township 30 Range 5-E

Well No. #1 Howard

Company Tulsa Okl

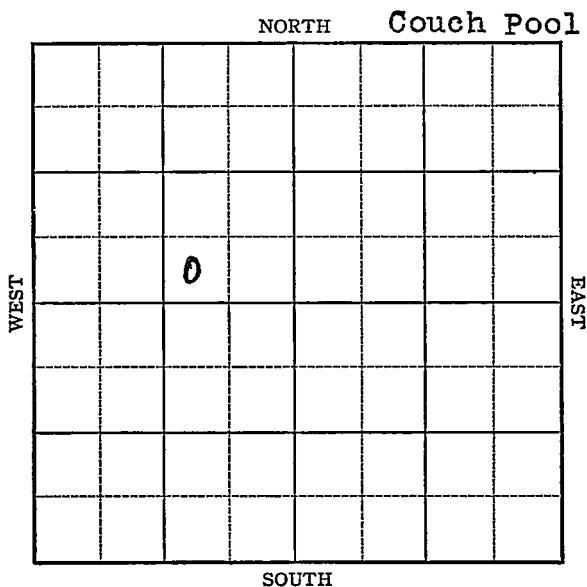


Sec. 12 Twp. 30 R. 5-EWell No. #1 Howard FarmTulsa Oil Company

(Couch)

 Ft. from N. Line330 Ft. from S. Line990 Ft. from E. Line Ft. from W. Line

Elev. 1360

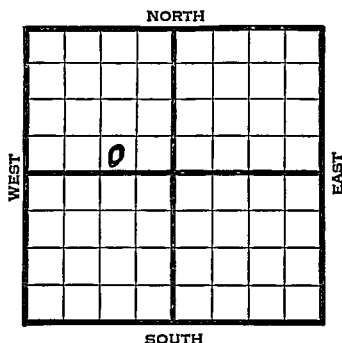

1941

REPORT

4/16

8" - 46'

Core 2790-2809' full recovery,
shale. Core 2809-29 full recd
shale. Shut down.

Drop core barrel.

4/24

Bart. 2830-39' 5" - 2830'
800' fluid.

5/1

T.D. 2845' Shot 30 qts. 2845-35'

Flow 222 oil 24 hours. C. O.

5/8

Run tubing & rods.

5/15

" " "

5/21

Bart. 2830'

5" - 2830'

T.D. 2845'

Shot 30 qts. 2845-35'

Potential 314 bbls., pump.

38. Gravity

COMPLETED

Map No. // Sec. 12 Twp. 30 R. 5EWell No. 1 HowardTulsa Oil

Company

Contractor

SECTION PLAT

SW SE NW

 Ft. from N. Line330 Ft. from S. Line990 Ft. from E. Line Ft. from W. Line

couch pool

Location Rig up

Drilling and Remarks:

8" - 46

Core 2790-2809

Full Recy. Shale

Core 2809-29

Full Recy. Shale

S.D. Drop Core
BB1.

RECORD

Cased in., ft.Sand Gas Oil Total Depth

PRODUCTION

1st 24 hrs. Nat. 1st 24 hrs. after shot Gas Cu. Ft.Dry Hole Abandoned

Date

APR 16 1941

19

S. J. LEWIS

Scout

Map No. 11 Sec. 12 Twp. 30 R. 5EWell No. 1 HowardTulsa Oil Corp. Company

Contractor

COMPLETED

SW SE NW

 Ft. from N. Line330 Ft. from S. Line990 Ft. from E. Line Ft. from W. Line

COUCH POOL

SECTION PLAT

Location Rig up

Drilling and Remarks:

Bar 2830
5" @ 2830
30 gts 2845-35
Pump .314 P

*38-9***RECORD**Cased in., ft.Sand Gas Oil Total Depth 2845**PRODUCTION**1st 24 hrs. Nat. 1st 24 hrs. after shot Gas Cu. Ft.Dry Hole Abandoned

Date

MAY 21 1941

19

S. J. LEWIS

Scout