


Cowley

FORM 51

Section 12 Township 30 **KANSAS** 5E  
Range

Well No. #3 Howard

Company E.H. Adair & Gross Drig.

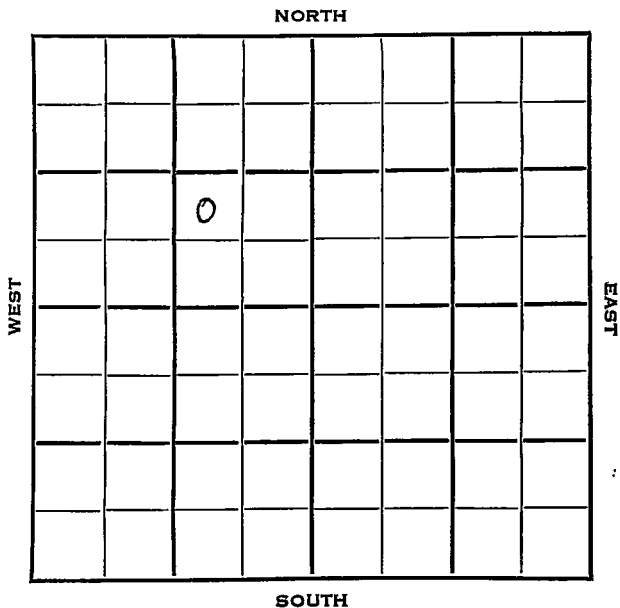

Cowley

KANSAS

SEC. 12	TWP. 30	R. 5E	✓
------------	------------	----------	---

WELL NO. #3 Howard FARM

COMPANY E.H. Adair & Gross Drlg.


CONTRACTOR Gross Drlg.

Couch Pool  
Ft. from N. Line

990 Ft. from S. Line

1140 Ft. from E. Line

Ft. from W. Line

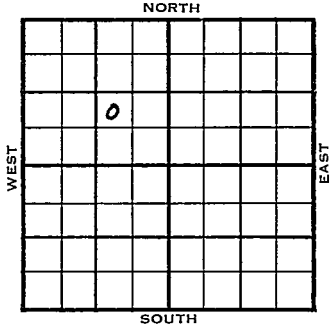

NW SE NW

1954	ELEVATION 1366'	REPORT
------	--------------------	--------

1/6 Spud 12-16-53  
 Oil Well  
 TD 2848'  
 8" @ 88'  
 KC 2212', B KC 2435', Big Lime 2525'  
 Oswego 2569', Cherokee 2654', Bart 2815'  
 Bart sd. 2831'  
 TD 2838'  
 5" @ 2832'  
 DD 2848'  
 sd-frac S/ 40 boph  
 Comp 25 bopd.

**FIRST REPORT  
 COMPLETED**

County **Cowley** State **Kansas**  
 Sec. **12** (Blk. Twp.) **30** (Sur. Rge.) **5E** Map No.  
 Operator **E. H. Adair & Gross Drlg.**  
 Well No. **3** Farm **Howard**  
 Elev. **1366** Location **NW SE NW**


**990** Ft. From **S** Line **NW**  
**1140** Ft. From **E** Line **Quarter**  
 Ist. Report **JAN 6 1954**  
 Completion **JAN 6 1954**  
 Remarks  
**Gross Drlg. - Contr.**  
 Spudding Date **12-16-53**

Drlg. Data **Oil well TD2848 Couch Pool**  
**8" @ 88 KC 2212 B KC 2435**  
**Big line 2525 Oswego 2569 Cherokee 2654**  
**Bart. 2815 Bart. sd. 2831 TD 2838**  
**5" @ 2832 DD 2848 sd-frac S/ 40 boph**  
**Comp. 25 bopd**

J. G. McGEHEE