
Butler KANSAS

SECTION 23 TOWNSHIP 28S RANGE 4E

WELL NO. #1 Dametz

COMPANY E. H. Adair

NE SW SW

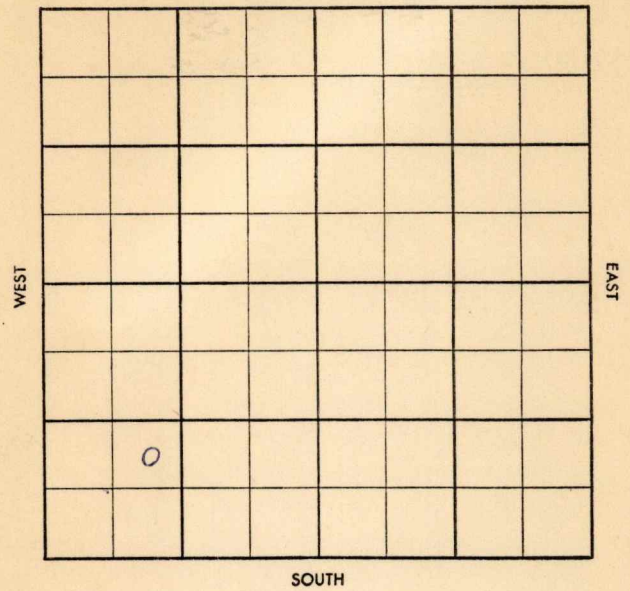


FORM 504-3 SUNRAY

Twp. X Pool X

Co. X Facet 39

S-513-B

County Butler Elev.

Sec. 23 Twp. 28 Rge. 4E

Company E. H. Adair

Farm Name Dametz No. 1

| TOPS | DEPTH | LOG | DATUM |
|---|---|---|---|
| Anh. | | | |
| Tp. | | | |
| H. | | | |
| Tr. | | | |
| Dg. | | | |
| B. L. | | | |
| L. | | | |
| K.C. | | | |
| B.K.C. | | | |
| Ce. | | | |
| C. | | | |
| M. | | | |
| M. | | | |
| K. | | | |
| Mz. | | | |
| Mq. | | | |
| V. | | | |
| S. | | | |
| S. | | | |
| A. | | | |
| R. | | | |
| Pf. | | | |
| G. | | | |
| T.D. | | | |

Loc. in Sec. NE SW SW

Geol.

Contr. Co. Tools

Pool Augusta

JUN 11 '58

FIRST REPORT

Date Comm. 6-5-58

8" @ 201, Drlg. 1460

Co. Lse. No. Sec. T. R.

Twp. X Pool X

Co. Y Facet X

S-513-B

County Butler Elev. 1258 or 1246

Sec. 23 Twp. 28 Rge. 4E

Company E. H. Adair

Farm Name Dametz No. 1

| TOPS | DEPTH | LOG | DATUM |
|---|---|---|---|
| Anh. | | | |
| Tp. | | | |
| H. | | | |
| Tr. | | | |
| Dg. | | | |
| B. L. | | | |
| L. | 1729 | | |
| K.C. | 2070 | | |
| B.K.C. | 2264 | | |
| Ce. | | | |
| C. | | | |
| M. | | | |
| M. | | | |
| K. | | | |
| Mz. | | | |
| Mq. | | | |
| V. | | | |
| S. sd | 2627 | | |
| S. | | | |
| A. | 2630 | | |
| R. | | | |
| Pf. | | | |
| G. | | | |
| T.D. | 2643 | | |

Loc. in Sec. NE SW SW

Geol.

Contr. Co. Tools

Pool Augusta

ABANDONED

JUN 18 '58

Date Comm. 6-5-58

8" @ 201, Drlg. 1460 JUN 18 '58 DST 2621-31 30" 4'M BHP 290 NT DST 2627-35 30" 4'M NOP DST 2629-39 15" 5'M BHP 810/30" DST 2633-43 60" 120'M 540' SW BHP 1040-980/30"

D&A

Co. Lse. No. Sec. T. R.