


Butler

KANSAS

SECTION 22 TOWNSHIP 28S RANGE 4E

WELL NO. #1 Purcell


COMPANY Bedell-Catt

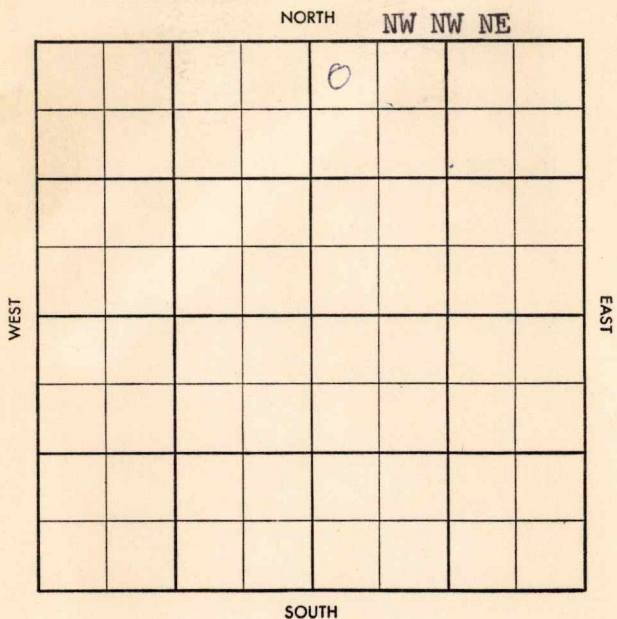

~~Top~~ ~~Pool~~
~~Co.~~ ~~Facet~~

S-513-B

County Butler Elev. 13400 = 131798
 Sec. 22 Twp. 28 Rge. 4E
 Company Bedell - Catt
 Farm Name Purcell No. 1

TOPS	DEPTH	LOG	DATUM	Loc. in Sec.
Anh.				NW NW NE
Tp.				
H.				
Tr.				
Dg.				
B.L.				
L.				
K.C.	<u>2077</u>			Geol.
B.K.C.	<u>2272</u>			Contr. <u>Gearhart</u>
Ce.				<u>Canady tools</u>
C.				
M.				
M.				Pool
K.				<u>Augusta</u>
Mz.				
Mq.				
V.				
S. <u>56</u>	<u>2663</u>			
S.				
A.	<u>2669</u>			
R.				
Pf.				
G.				
T.D.	<u>2695</u>			<u>JUL 23 '58</u>

Date Comm. 7-12-58 8" 146
 Location JUL 16 '58 1750 JUL 23 '58

D6A

Co.
No.
Sec.
T.
R.

