


Section 12

Township 30

Range 5E

Well No. #1-B Howard

Company E. H. Adair & B. B. Blair

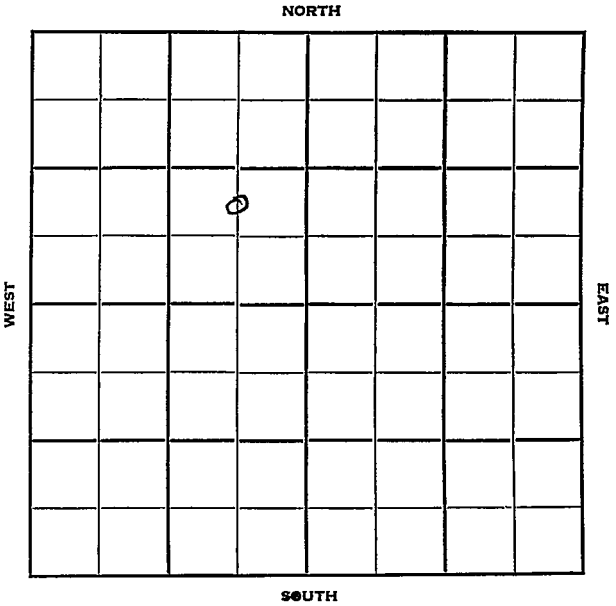

Cowley

KANSAS ✓

Sec. 12 Twp. 30 R. 5E

Well No. #1-B Howard Farm

E.H. Adair & B.B. Blair Company

Gross Drlg. - Contr. Contractor


 Ft. from N. Line

990' Ft. from S. Line

660' Ft. from E. Line

 Ft. from W. Line

C N L SE NW

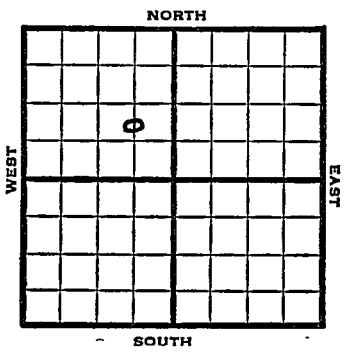

1952

Elev. 1361' REPORT

7/9

Spud 7-6-52
8" @ 105
Drlg. 840'

8/6

Spud 7-6-52
Oil Well TD 2846
8" @ 105
KC 2193 BKG 2425
Big Lime 2517 Oswego 2566
Bart 2835
5" @ 2836 DD 2846 FU 1650' oil
12 hr. S/2 boph Hydro P/7 boph
F 4 boph Comp. F/100 bopd

COMPLETED

