


Section 29 Township 13 Range 14W

Well No. #1 Miller

Company Wamhoff & Gear etal.

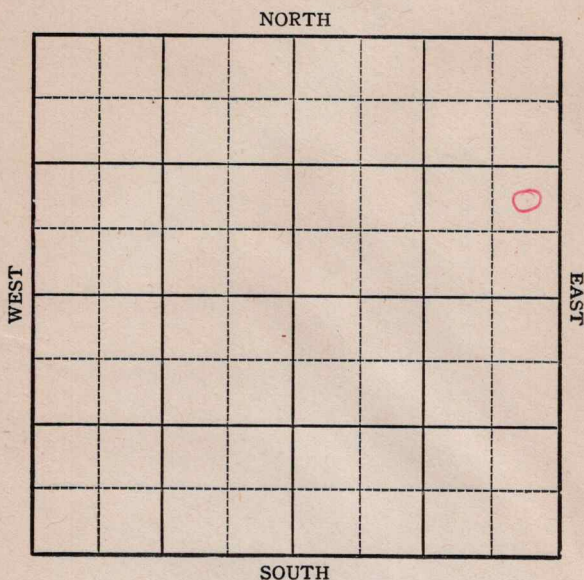

Russell

Sec. 29 Twp. 13 R. 14W

Well No. #1 Miller Farm

Wamhoff & Gear etal. Company


Russell

Ft. from N. Line

990 Ft. from S. Line

330 Ft. from E. Line

Ft. from W. Line

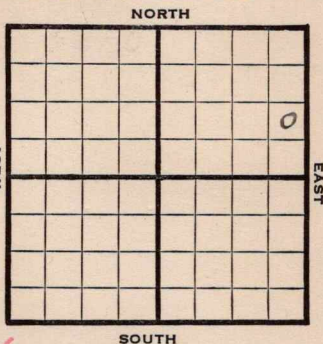

Elev. 1856

1944

REPORT

5/3	Cellar	
5/10	"	
5/17	"	
5/24	"	
5/31	Spud	
6/7	12" @ 351	
	Drlg. 765	
6/15	10' @ 908	
	Anhy 913	
	Drlg. 1630	
6/21	Drlg. 2390'	
6/28	Gas 2420	
	8" @ 2473	
	Drlg 2745	
7/12	Lans 3015	3027 fsg
7/19	3106 Run 7"	
7/26	7" @ 3106	Drlg. 3282
8/2	Arb 3280	
	TD 3294	7" @ 3284 RUS T
8/9	TD 3294-	2800' oil
8/16	" "	" "

OVER

732443

1944

8/23 Arb 3280
7" @ 3284
500 acid
TD 3294
Pump 500 Pot.
Grav. 36.6


COMPLETED

KANSAS

Pool Name RussellMap No. 72 Sec. 29 Twp. 13 R. 14WWell No. 1 MillerWamhoff & Gear etal. CompanyFIRST REPORT Contractor

NE SE NE

SECTION PLAT

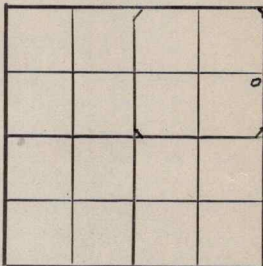 Ft. from N. Line990 Ft. from S. Line330 Ft. from E. Line Ft. from W. LineRussell County

RECORD

Location Cased in., ft.Rig up Sand

Drilling and Remarks:

Gas CellarOil Total Depth

PRODUCTION

1st 24 hrs. Nat 1st 24 hrs. after shot Gas Cu. Ft.Dry Hole Abandoned

Date

MAY 3 1944 19S. J. LEWIS Scout

Pool Name RussellMap No. 72 Sec. 29 Twp. 13 R. 14WWell No. 1 MillerWamhoff & Gear etal.

Company

COMPLETED

Contractor

NE SE NE

SECTION PLAT

			o

Ft. from N. Line

990

Ft. from S. Line

330

Ft. from E. Line

Ft. from W. Line

Russell County

Location

Rig up

Drilling and Remarks:

Cor 732807" @ 3284500 acidPump 500 Bx.36 1/2

RECORD

Cased _____ in., _____ ft.

Sand _____

Gas _____

Oil _____

Total Depth 3294

PRODUCTION

1st 24 hrs. Nat. _____

1st 24 hrs. after shot _____

Gas _____ Cu. Ft.

Dry Hole _____

Abandoned _____

Date

AUG 23 1944

19

S. J. LEWIS

Scout