

KANSAS


FORM 51 5M. 10-41 PETROL

Cowley

Section 12 Township 30 Range 5-E

Well No. #1 Kennedy

Company Leavell Coal

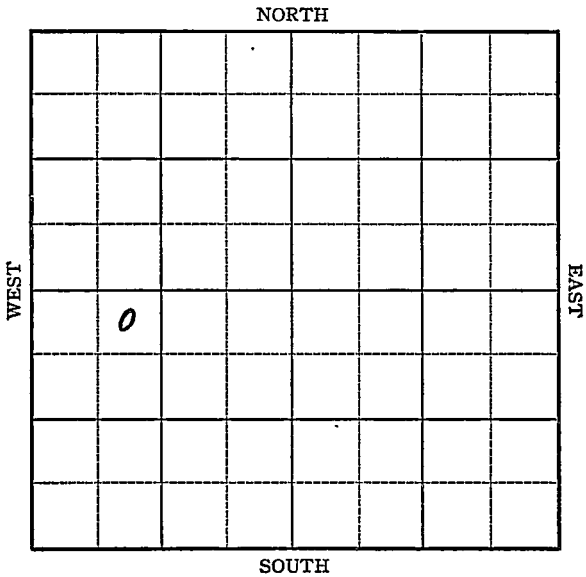


Map No. 11-77 Sec. 12 Twp. 30 R. 5EWell No. 1 KennedyLeavell Coal Company~~FIRST REPORT~~ Contractor

NE NW SW

330 Ft. from N. Line Ft. from S. Line Ft. from E. Line990 Ft. from W. Line

SECTION PLAT

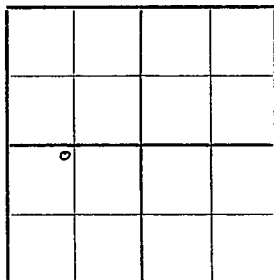

COUCH POOL

Location Rig up

Drilling and Remarks:

10" - 111'Drlg. 860'

RECORD

Cased in., ft.Sand Gas Oil Total Depth

PRODUCTION

1st 24 hrs. Nat. 1st 24 hrs. after shot Gas Cu. Ft.Dry Hole Abandoned

Date

NOV 12 1941₁₉S. J. LEWIS Scout

Cowley

KANSAS

Map No. 11 Sec. 12 Twp. 30 R. 5EWell No. 1 KennedyLeavell Coal CompanyCOMPLETED Contractor

NE NW SW

330 Ft. from N. Line Ft. from S. Line Ft. from E. Line990 Ft. from W. Line

SECTION PLAT

6			

COUCH POOL

Location Rig up

Drilling and Remarks:

*Bar 2825.**7" @ 2825.**259 ft.**Pump & Flow 1548
P.Y.**4/5/42*

RECORD

Cased in., ft.Sand Gas Oil Total Depth 2843

PRODUCTION

1st 24 hrs. Nat. 1st 24 hrs. after shot Gas Cu. Ft.Dry Hole Abandoned

Date

DEC 30 1941 19S. J. LEWIS Scout