


Cowley

KANSAS

SECTION 12 TOWNSHIP 30 RANGE 5 E

WELL NO. #9 Kennedy

COMPANY Stelbar Oil

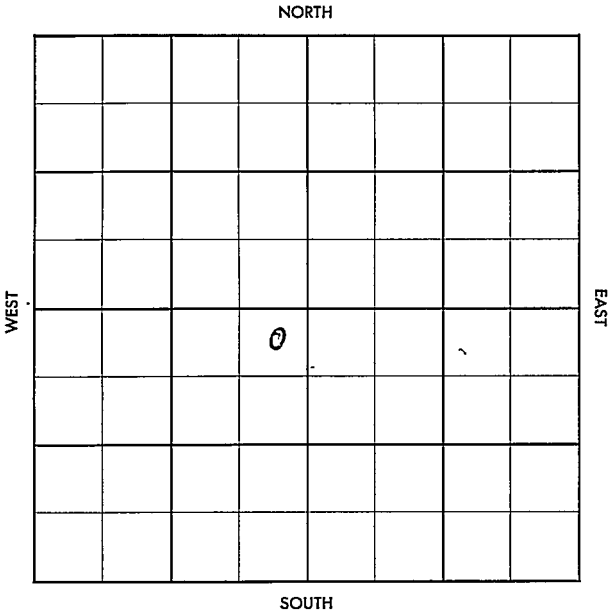

Cowley

KANSAS

SEC. 12	TWP. 30	R. 5E
------------	------------	----------

WELL NO.

#9 Kennedy

FARM

COMPANY

Stelbar Oil

CONTRACTOR

Co. Tools

Couch


Ft. from N. Line

Ft. from S. Line

Ft. from E. Line

Ft. from W. Line

NE NE SW

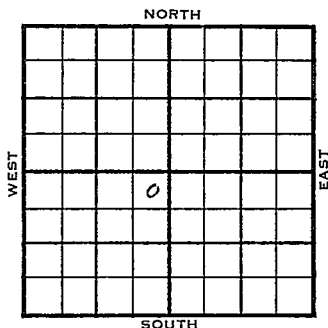

	ELEVATION	REPORT
--	-----------	--------

1955 1360 DF, 1362 RB

12-7 Comm. 11-29-55
8" @ 126/755
Coring
KC 2191
BKC 2420

12-21 5½" @ 2835/100
GO to 2860
Comp. water input well
Bart 2812
TD 2860'

ABANDONED

County Cowley Elev. 1362 RB
 Sec. 12 Twp. 20 Rge. 5 E
 Company Stelbar Oil
 Farm Name Kennedy No. 9

TOPS	DEPTH	LOG	DATUM
Anh.			
TP.			
H.			
Tr.			
Dg.			
BL.			
L.			
K.C.	2191		
B.K.C.	2120		
Ce.			
C.			
M.			
M.			
K.			
Mz.			
Mq.			
V.			
S.			
S.			
A.			
R.			
PE.			
G.			
T.D.			

Loc. in Sec. _____

NE NE SW

50' NL

50' EL

Geol. _____

Contr. _____

Co. tools

Pool _____

Couch

FIRST REPORT	
o	
DEC 7 '55	

Date Comm. 11-29-55
8" @ 126/755 Coreing

1360 DF

1362 RB

County Cowley

Elev.

Sec. 12Twp. 30Rge. 5ECompany Stelbar OilFarmName KennedyNo. 9

TOPS	DEPTH	LOG	DATUM
Anh.			
Tr.			
H.			
Tr.			
Dg.			
Bl.			
L.			
K.C.	<u>2191</u>		<u>829</u>
B.K.C.	<u>2420</u>		<u>1058</u>
Ce. <u>BAIT</u>	<u>2812</u>		<u>1450</u>
C.			
M.			
M.			
K.			
Mz.			
Ma.			
V.			
S.			
S.			
A.			
R.			
Pe.			
G.			
T.D.	<u>2860</u>		

Loc. in Sec.

NE NE SW50' NL50' EL

Geol.

Contr.

Co. tools

Pool

CouchCOMPLETE0ABANDONEDDate Comm. 11-29-55

DEC 21 1955

8" @ 126/755 5 1/2" @ 2835/100GO to 2860 Comp. water input well