


Section 12 Township 30 Range 5E

Well No. 6 Victory Life

Company Ryan Consolidated

Misc.

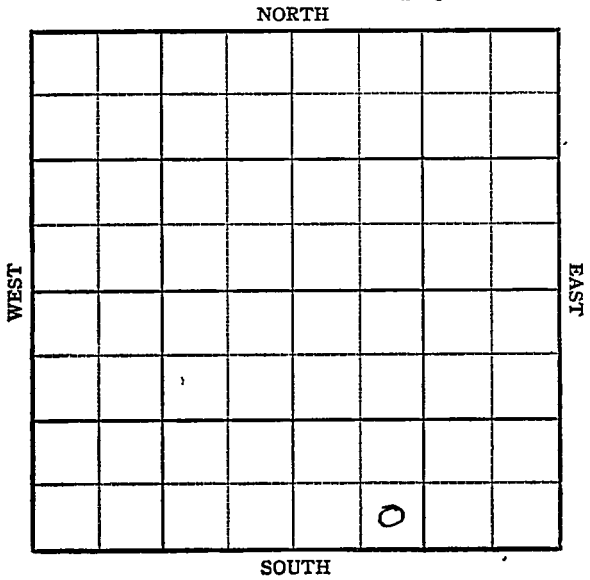

Sec. 12 Twp. 30 R. 5-E ✓

Well No. #6 Victory Life Farm

Ryan Consolidated Company

Miscellaneous


 Ft. from N. Line

330 Ft. from S. Line

 Ft. from E. Line

990 Ft. from W. Line

SE SW SE

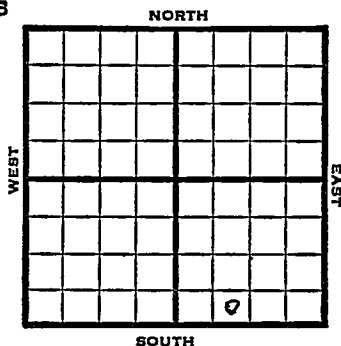

1948

Eli 1252'

REPORT

9/29

8" @ 125'

Drlg 881'

10/6

Drlg. 2010'

10/13

TD 2855'

5" @ 2820'

10/19

KC 2210'

TD 2870'

10/27

TD 2870'

Bart Zone 2872'

Aband.

ABANDONED


Map No. _____ Sec. 12 Twp. 30 R. 5EWell No. 6 Victory LifeRyan Consolidated Company

FIRST REPORT

Contractor

SE SW SE

SECTION PLAT

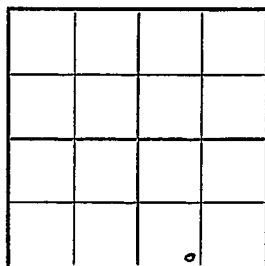

_____ Ft. from N. Line

330 Ft. from S. Line

_____ Ft. from E. Line

990 Ft. from W. LineCowley County

Location _____

Rig up _____

Drilling and Remarks:

8" @ 125

drlg. 881

RECORD

Cased _____ in., _____ ft.

Sand _____

Gas _____

Oil _____

Total Depth _____

PRODUCTION

1st 24 hrs. Nat. _____

1st 24 hrs. after shot _____


Gas _____ Cu. Ft.

Dry Hole _____

Abandoned _____

Date

SEP 29 1948 19S. J. LEWIS Scout

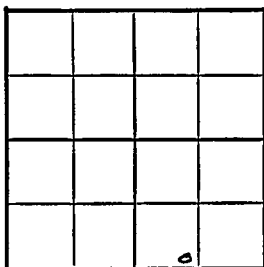Map No. 11 Sec. 12 Twp. 30 R. 5EWell No. 6 Victory LifeRyan Consolidated Company**ABANDONED**SE SW SE ContractorE1, 122
SECTION PLAT Ft. from N. Line330 Ft. from S. Line Ft. from E. Line990 Ft. from W. LineCowley CountyLocation Rig up

Drilling and Remarks:

Bar Zone 2512**RECORD**Cased in., ft.Sand Gas Oil Total Depth 2870**PRODUCTION**1st 24 hrs. Nat. 1st 24 hrs. after shot Gas Cu. Ft.Dry Hole Abandoned

Date

OCT 27 1948 19S. J. LEWIS Scout