


Section 12 Township 30S Range 5E

Well No. #4 Victory Life Ins A

Company Stelbar Oil

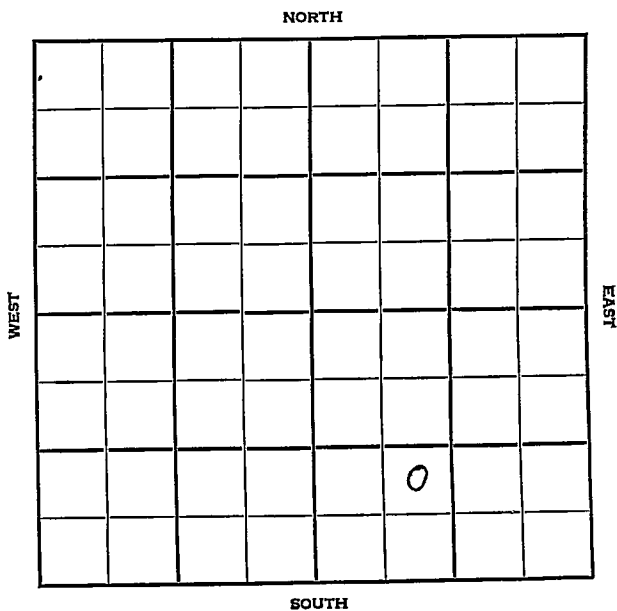


SEC.	TWP.	R.
12	30	5E

WELL NO #4 Victory Life Ins. "A" FARM

COMPANY Stelbar Oil

CONTRACTOR Co. Tools Couch

_____ Ft. from N. Line
 _____ Ft. from S. Line
 _____ Ft. from E. Line
 _____ Ft. from W. Line

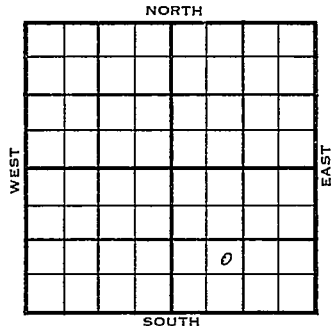

NE SW SE

1955	ELEVATION 1361'	REPORT
------	--------------------	--------

9/7	Comm 8-31-55 8" @ 67 Drlg 2700
10/12	Comm 8-31-55 8" @ 67 5 1/2" @ 1979 17/1824-33 20/1868-79 Comp SW supply well

COMPLETED

County Cowley 11 Elev. _____
 Sec. 12 Twp. 30 Rgs. 5E
 Company Stelbar Oil
 FarmName Victory Life Ins. "A" No. 4

TOPS	DEPTH	LOG	DATUM
Anh.			
Tp.			
H.			
Tr.			
Dg.			
Bl.			
L.			
K.C.			
B.K.C.			
Ce.			
C.			
M.			
M.			
K.			
Mz.			
Me.			
V.			
S.			
S.			
A.			
R.			
PE.			
G.			
T.D.			

Loc. in Sec. NE SW SE

Geol. _____

Contr. _____

Co. tools

Pool Couch

FIRST REPORT

Date Comm. 8-31-55
8" @ 67 drlg. 2700

Co.
 No.
 Sec.
 T.
 R.

County Cowley Elev. 1361
 Sec. 12 Twp. 30 Rge. 5E
 Company Stelbar Oil
 FarmName Victory Life Ins. "A" No. 4

TOPS	DEPTH	LOG	DATUM
Anh.			
Tr.			
H. <u>Stal</u>	<u>1824</u>		<u>463</u>
Tr.			
Dg.			
Bl.			
L.			
K.C.	<u>2188</u>		<u>827</u>
B.K.C. <u>Bank</u>	<u>2849</u>		<u>1488</u>
Ce.			
C.			
M.			
M.			
K.			
Mz.			
Mq.			
V.			
S.			
S.			
A.			
R.			
PE.			
G.			
T.D.	<u>2856</u>		

Loc. in Sec. _____
 NE SW SE
 Geol. _____
 Contr. _____
 Co. tools _____
 Pool _____
 Couch _____

ABANDONED

Date Comm. 8-31-55 OCT 12 1955
8" @ 67 5 1/2" @ 1979 17" 1824-33
20/ 1868-79 Comp. SW supply well

Co.
Lse.
No.
Sec.
T.
R.