


Section 13 Township 30 Range 5-E

Well Number 1 Couch


Company Ryan Consolidated

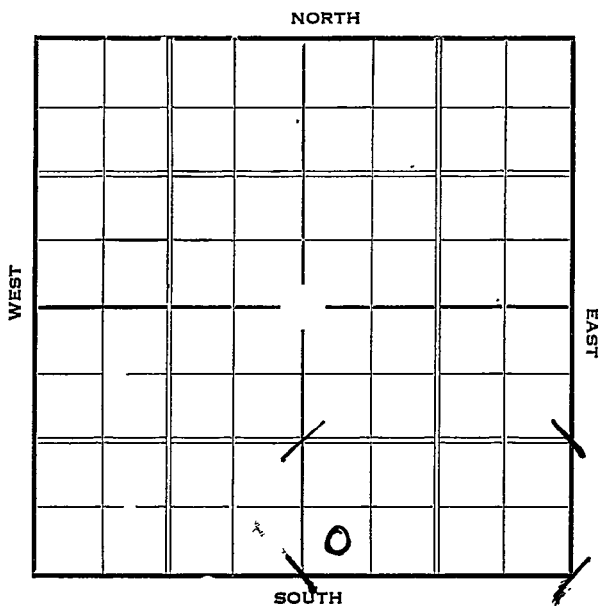

Sec. 13 Twp. 30 R. 5-E

Well No. #1 Couch Farm
Ryan Consolidated Company

_____ Ft. from N. Line
330 Ft. from S. Line .
 _____ Ft. from E. Line
330 Ft. from W. Line .
 Elev. 1313

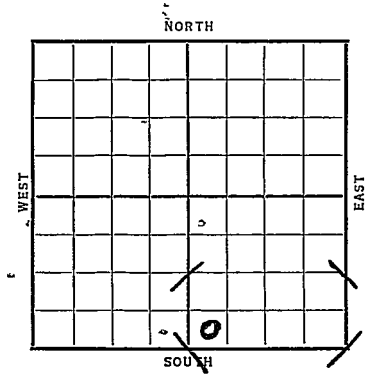

Date 1937

REPORT

<u>3/3</u>	Location
<u>3/11</u>	Mach.
<u>3/18</u>	Drlg. 175'
<u>3/25</u>	Drlg. 900'. 15" @ 300'.
<u>4/2</u>	12" @ 1407'. Drlg. 1520'
<u>4/8</u>	Drlg. 2050'
<u>4/16</u>	2418' underream 6".
<u>4/23</u>	Bart. Sd. 2796'.
	T.D. 2842'.
	Shot 50 qts. No test.
<u>4/30</u>	5" @ 2795'. Swabbed 70 oil & 20 water. 19 hrs. Clean out.
<u>5/7</u>	Pumping 15 oil 10 water per day.

OVER

1937

5/12

Bart. 2796'.

Pay 2807-42'.

T.D. 2842'.

Shot 50 qts.

Pot. 43 bbls. 24 hrs.

COMPLETED

Cowley
 Map No. J11 Sec. 13 Twp. 30 R. 5E

Well No.: 1 Couch

Ryan Consolidated Company

Contractor

SECTION PLAT

_____ Ft. from N. Line

330 Ft. from S. Line

_____ Ft. from E. Line

330 Ft. from W. Line

FIRST REPORT

Location ✓

Rig up _____

Drilling and Remarks:

RECORD

Cased, _____ in., _____ ft.

Sand _____

Gas _____

Oil _____

Total Depth _____

PRODUCTION

1st 24 hrs. Nat. _____

1st 24 hrs. after shot _____

Gas _____ Cu. Ft.

Dry Hole _____

Abandoned _____

Date

MAR 3 1937 19

S. J. LEWIS
 Scout

Cowley **KANSAS**

Map No. 11 Sec. 13 Twp. 30 R. 5^E

Well No. 1 - Couch

Ryan Consolidated Company
Contractor

COMPLETED

SECTION PLAT

_____ Ft. from N. Line
330 Ft. from S. Line
_____ Ft. from E. Line
330 Ft. from W. Line

		0	

Location _____

Rig up _____

Drilling and Remarks:

SHOT - 50 gts

POT - 43/24 hrs

RECORD

Cased _____ in., _____ ft.
Sand Bart 2796
Gas Pay - 2807-42
Oil _____
Total Depth 2842

PRODUCTION

1st 24 hrs. Nat. _____
1st 24 hrs. after shot _____
Gas _____ Cu. Ft.
Dry Hole _____
Abandoned _____

Date

MAY 12 1937

H. D. Hatfield

Scout