

KANSAS


Form 51-5M-7-39-Palace

Cowley

Section 13 Township 30 Range 5-E

Well No. #1 Couch

Company Ryan Consolidated

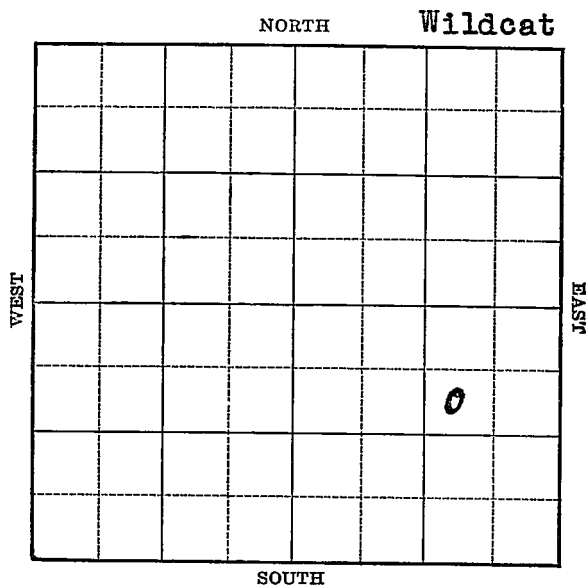

SOUTH

COMPLETED

Map No. // Sec. 13 Twp. 30 R. 5EWell No. 1 CoughRyan Consolidated Company

Contractor


FIRST REPORT

SW NE SE

990 Ft. from N. Line Ft. from S. Line990 Ft. from E. Line Ft. from W. Line

WILDCAT

SECTION PLAT

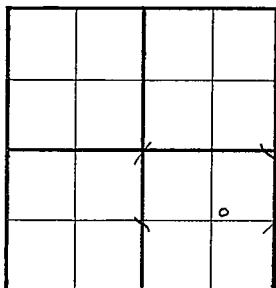Location XRig up

Drilling and Remarks:

RECORD

Cased in., ft.Sand Gas Oil Total Depth

PRODUCTION

1st 24 hrs. Nat. 1st 24 hrs. after shot Gas Cu. Ft.Dry Hole Abandoned

Date

APR 2 + 1940 19 S. J. LEWIS Scout

Map No. 11 Sec. 13 Twp. 30
~~20~~ R. 5EWell No. 1 Couch

Ryan Consolidated Company

Contractor

SW NE SE
COMPLETED

SECTION PLAT

990 Ft. from N. Line Ft. from S. Line990 Ft. from E. Line Ft. from W. Line

WILDCAT

Location Rig up

Drilling and Remarks:

*Bar tank 2776**8" @ 2757**Flow & Pump 246 Bx.*

RECORD

Cased in., ft.Sand Gas Oil Total Depth 2800

PRODUCTION

1st 24 hrs. Nat. 1st 24 hrs. after shot Gas Cu. Ft.Dry Hole Abandoned

Date

MAY 22 1940

S. J. LEWIS

Scout

Check township. First report
shows 13-30-5E

Paul.

Misc. Small Maps.....	X
Cards.....	Paul
Tracing.....	CRK
France Map.....	J. R. M.
Scarborough Map.....	J. R. M.
Moody Map.....	J. R. M.
Geological Dept.	
Moody Flat Book	