

KANSAS

Form 51-5M-7-39-Palace


Cowley

Section 13 Township 30 Range 5-E

Well No. #3 Couch

Company Ryan Consolidated

NORTH **M**iscellaneous

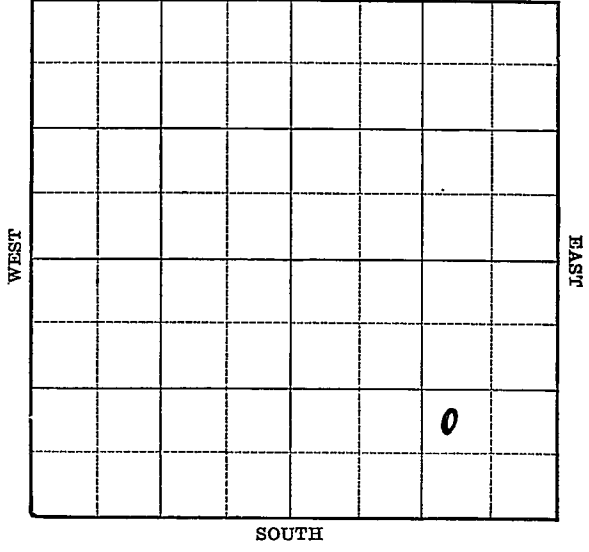

Sec. 13 Twp. 30 R. 5-E

Well No. #3 Couch Farm
Ryan Consolidated Company


(Misc.)

_____ Ft. from N. Line

99.0 Ft. from S. Line

990 Ft. from E. Line

_____ Ft. from W. Line

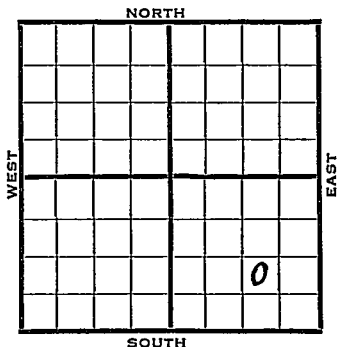

Elev. 1319

1940	REPORT
5/22	Location
5/29	"
6/6	"
6/13	13" - 198' Drlg. 470'
6/20	Drlg. 2501'
6/27	Bart. 2769 ²⁷⁷¹ T.D. 2769 ²⁷⁷¹ 7" - 2769 ²⁷⁷² _{1/2} ' RUST.
7/3	Bart. 2771-87' T.D. (Corrected) S.O. 7" - 2772'
7/11	Shot 20 qts. 2775-85' 1800' oil 1 hour.
7/18	SD 2819'
7/24	Bart. 2771' 7" - 2772' T.D. 2819' Shot 20 qts. 2775-85' Pump 328 bbls.
	COMPLETED

Map No. 11 Sec. 13 Twp. 30 R. 5EWell No. 3 CouchRyan Consolidated Company

Contractor

FIRST REPORT

NW SE SE

 Ft. from N. Line990 Ft. from S. Line990 Ft. from E. Line Ft. from W. Line**SECTION PLAT**

			o

MiscellaneousLocation XRig up

Drilling and Remarks:

RECORDCased in., ft.Sand Gas Oil Total Depth **PRODUCTION**1st 24 hrs. Nat. 1st 24 hrs. after shot Gas Cu. Ft.Dry Hole Abandoned

Date

MAY 22 1940 19S. J. LEWIS Scout

