

Form 51-5M-2-29-34703


Butler

Map No. **KANSAS** Sec. *27* Twp. *28* R. *4E*

Well No. *J. Martin* Farm

Shenck Hills Oil Company

NORTH

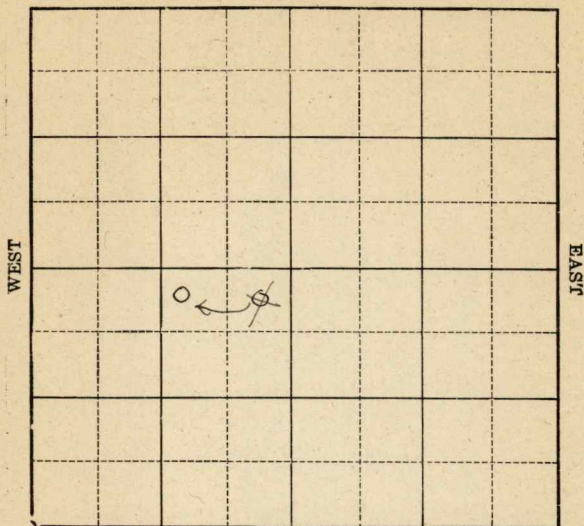

SOUTH

Location _____
Drilling Remarks _____

Rig Up _____
Drilling Remarks _____

RECORD

PRODUCTION

Cased _____ in. _____ ft.
Sand _____
Gas _____
Oil _____
Total Depth _____

1st 24 hrs. Nat. _____
1st 24 hrs. after shot _____
Gas _____ cu. ft.
Dry Hole _____
Abandoned _____

Map No. KANSAS Sec. 27 Twp. 28 R. 4^E

Well No. 2-Martin Farm
Slint Hills Oil Company

NORTH

750 Ft. from N. Line


Ft. from S. Line

~~750~~
¹¹²⁰
750

Ft. from E. Line

Ft. from W. Line

1931

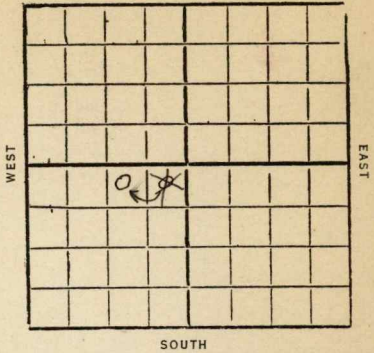

Date

REPORT

| Date | REPORT |
|------|--|
| 8/26 | Loc |
| 9/2 | Spdg |
| 9/9 | Fishing at 510' |
| 9/16 | Drig 1200' |
| 9/23 | 510 1200' |
| 9/30 | |
| 10/7 | Land 1475-1521 117 1521 1 st gas Comp. |

Butler

E

KANSAS

Map No. _____ Sec. 27 Twp. 28 R. 4

Well No. 2 Martin

Flint Hills Oil Co. Company

Contractor

FIRST REPORTS

SECTION PLAT

250 Ft. from N. Line

_____ Ft. from S. Line

250 Ft. from E. Line

_____ Ft. from W. Line

| | | | |
|--|---|--|--|
| | | | |
| | | | |
| | o | | |
| | | | |

Location ✓

Rig up

Drilling and Remarks:

RECORD

Cased _____ in., _____ ft.

Sand _____

Gas _____

Oil _____

Total Depth _____

PRODUCTION

1st 24 hrs. Nat. _____

1st 24 hrs. after shot _____

Gas _____ Cu. Ft.

Dry Hole _____

Abandoned _____

Date

AUG 26 1931

CHAS. L. SHERWOOD

192

Scout

Butler

E

KANSAS

Map No. Sec. 27 Twp. 28 R. 4

Well No. 2 Martin

Flint Hills Oil Co Company

Contractor

CORRECTION

250 Ft. from N. Line

Ft. from S. Line

170 Ft. from E. Line

Ft. from W. Line

SECTION PLAT

| | | | |
|--|-----|--|--|
| | | | |
| | | | |
| | 050 | | |
| | | | |

Location

Rig up

Drilling and Remarks:

Change Location

RECORD

Cased in., ft.

Sand

Gas

Oil

Total Depth

PRODUCTION

1st 24 hrs. Nat.

1st 24 hrs. after shot

Gas Cu. Ft.

Dry Hole

Abandoned

Date

SEP 30 1931

CHAS. L. SHERWOOD

192

Scout

Butler

Map No. **KANSAS** Sec. 27 Twp. 28 R. 4 ^E

Well No. 2 Martin

Fling Hills Oil Co Company

Contractor

COMPLETED

SECTION PLAT

250 Ft. from N. Line
Ft. from S. Line
1120 Ft. from E. Line
Ft. from W. Line

| | | | |
|--|---|--|--|
| | | | |
| | | | |
| | 0 | | |
| | | | |

Location

Rig up

Drilling and Remarks:

RECORD

Cased in., ft.
Sand 1475-1521
Gas
Oil
Total Depth 1521

PRODUCTION

1st 24 hrs. Nat.
1st 24 hrs. after shot
Gas 1 ~~M~~ Cu. Ft.
Dry Hole
Abandoned

Date

OCT 7 1931 CHAS. L. SHERWOOD Scout