


Butler
Form 51-5M-2-29-34703
Map No. **KANSAS** Sec. 27 Twp. 28 R. 4E
Well No. 3- Martin Farm
Glent Hills Oil Company

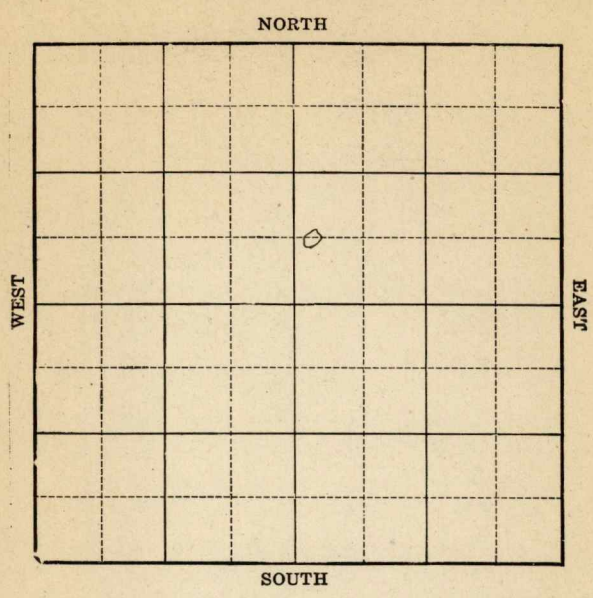

Location _____
Drilling Remarks _____

Rig Up _____
Drilling Remarks _____

RECORD

Cased _____ in. _____ ft.
Sand _____
Gas _____
Oil _____
Total Depth _____

PRODUCTION

1st 24 hrs. Nat. _____
1st 24 hrs. after shot _____
Gas _____ cu. ft.
Dry Hole _____
Abandoned _____

Map No. **KANSAS** Sec. 27 Twp. 28 R. 4^E
Well No. 3-Martin Farm
Shint Hills Oil Company


_____ Ft. from N. Line

660 Ft. from S. Line

_____ Ft. from E. Line

200 Ft. from W. Line

1931

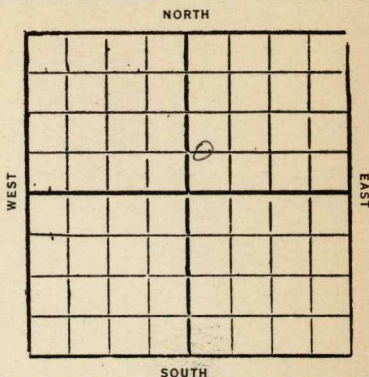

Date

REPORT

11/4	Stg 6"-1155'
11/10	5"-1478
11/18	SD 1584
11/24	SD 1524
11/24	5"-1478
	Sand 1478-1524
	TD 1524
	1/2 M gas
	Comp

Butler

 11 KANSAS
 Map No. _____ Sec. 27 Twp. 28 R. 4 E

 Well No. 3 Martin
 Flint Hills Oil Co Company

Contractor

FIRST REPORTS

SECTION PLAT

		0	

Ft. from N. Line

660 Ft. from S. Line

Ft. from E. Line

200 Ft. from W. Line

Location

Rig up

Drilling and Remarks:

Avg 6" 1155

RECORD

Cased _____ in., _____ ft.

Sand _____

Gas _____

Oil _____

Total Depth _____

PRODUCTION

1st 24 hrs. Nat. _____

1st 24 hrs. after shot _____

Gas _____ Cu. Ft.

Dry Hole _____

Abandoned _____

Date

NOV 4 1931 CHAS. L. SHERWOOD

192

Scout

11 **KANSAS** *Butler*
 Map No. _____ Sec. *27* Twp. *28* R. *4* ^E

Well No. *3 Martin*
Flinn Hills Oil Co Company

Contractor _____

COMPLETED**SECTION PLAT**

		0	

_____ Ft. from N. Line

660 Ft. from S. Line

_____ Ft. from E. Line

200 Ft. from W. Line

Location _____

Rig up _____

Drilling and Remarks:

RECORDCased *5* in., *1478* ft.Sand *1478-1524*

Gas _____

Oil _____

Total Depth *1524***PRODUCTION**

1st 24 hrs. Nat. _____

1st 24 hrs. after shot _____

Gas *1 1/2* *MT* Cu. Ft.

Dry Hole _____

Abandoned _____

Date

NOV 24 1931**CHAS. L. SHERWOOD**

19

Scout